

Washington
 Q20
 4-7-67

MISSISSIPPI
 BOARD OF WATER COMMISSIONERS
 416 North State Street
 Jackson, Mississippi 39201

5/17/67
 Jm
 E2412

WATER WELL DRILLERS LOG

April 7, 1967 Layne-Central Company Washington
 date well completed firm name county well located

LANDOWNER: Frey Farms, Inc.

Hollandale, Mississippi

(mailing address)

description of formations encountered

from to

Clay	10	15
Sand	15	35
Coarse sand	35	58
Coarse sand, pea gravel	58	79
Coarse sand, gravel	79	122

WELL LOCATION:


sec. 17 T. 15 N. R. 5 E. W.
 6 miles east of Hollandale
 (distance) (direction) (nearest town)

WELL PURPOSE: irrigation
 (home, irrigation, municipal, industrial)

WELL COMPLETION DATA:

- (1) diameter (inches) 16
- (2) total depth (feet) 122
- (3) static water level (feet) 21' 6" above top of ground.
- (4) casing steel, 72' (material), (depth), 16" (size) if telescope see back.
- (5) screen 50', 122' (length), (depth to top), 16" (size), Armco (material)
- (6) pump 50 (HP), 2500 (yield gpm), engine (type power)
- (7) electric log no (yes or no), (organization running log)
- (8) how well bottom plugged plate

DRILLERS REMARKS:

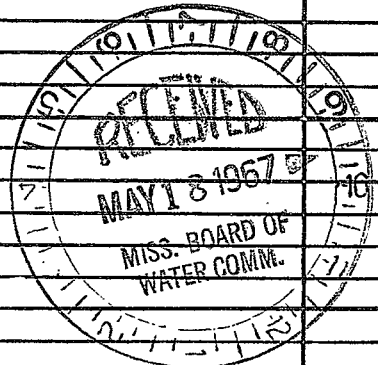

If well telescopes please sketch and show depths.

GROUND LEVEL

SECTION _____

Please indicate well location X.

ADDITIONAL INFORMATION

If more than one screen,
show locations of each on sketch.