

Washington  
 Q 29  
 4-11-67

MISSISSIPPI  
 BOARD OF WATER COMMISSIONERS  
 416 North State Street  
 Jackson, Mississippi 39201

5/17/67  
 C 2417

WATER WELL DRILLERS LOG

April 11, 1967 Layne-Central Company Washington  
 date well completed firm name county well located

LANDOWNER: Willett Plantation  
 Hollandale, Mississippi

description of formations encountered	from	to
Clay	0	32
Coarse sand	32	67
Coarse sand, pea gravel	67	96
Coarse sand, pea gravel, big gravel	96	122

(mailing address)

WELL LOCATION:


sec. 30 T. 15 N. R. 5 E  
 S W  
 7 miles SE of Hollandale  
 (distance) (direction) (nearest town)

WELL PURPOSE: irrigation  
 (home, irrigation, municipal, industrial)

WELL COMPLETION DATA:

- (1) diameter (inches) 16
- (2) total depth (feet) 122
- (3) static water level (feet) 23' 7" above top of ground.
- (4) casing steel, 72' (material), (depth), 16" (size) if telescope see back.
- (5) screen 50' (length), 122' (depth to top), 16" (size), Armco (material)
- (6) pump 50 (HP), 2400 (yield gpm), engine (type power)
- (7) electric log no (yes or no), (organization running log)
- (8) how well bottom plugged plate

DRILLERS REMARKS:

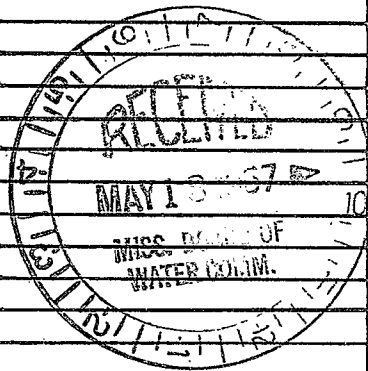

If well telescopes please  
sketch and show depths.

GROUND LEVEL


SECTION \_\_\_\_\_

Please indicate well location X.

ADDITIONAL INFORMATION

If more than one screen,  
show locations of each on sketch.