

*Washington*  
933  
9-67

MISSISSIPPI  
 BOARD OF WATER COMMISSIONERS  
 416 North State Street  
 Jackson, Mississippi 39201

WATER WELL DRILLERS LOG

9/25 1967 Dyer Well & Irr. Ser. Washington  
 date well completed firm name county well located

LANDOWNER: Dave Jones

R. R. Isola,

Mississippi  
 (mailing address)

WELL LOCATION:

sec. 3 T. 15 N. R. 5 ~~XX~~  
 S. W.  
8 miles East of Hollandale  
 (distance) (direction) (nearest town)

WELL PURPOSE: Home  
 (home, irrigation, municipal, industrial)


WELL COMPLETION DATA:

- (1) diameter (inches) 4" x 2 1/2"
- (2) total depth (feet) 881 Ft.
- (3) static water level (feet) 11' below  
top of ground.
- (4) casing 4" Blk. 2" Galv. 861'  
(material) (depth)  
         if telescope see back.  
(size)
- (5) screen 20 Ft. 861 Ft.  
(length) (depth to top)  
2" Stainless Steel  
(size) (material)
- (6) pump 1 1/2 HP 35 GPM  
(HP) (yield gpm)  
Electric Submers. pump  
(type power)
- (7) electric log No  
(yes or no)  
          
(organization running log)
- (8) how well bottom plugged Valve

description of fomations  
 encountered

from to


Clay	0	31
Sand	31	98
Sand & Pea Gravel	98	135
Large Gravel & Sand	135	195
Shale Sandy Streaks	195	310
Sand	310	490
Gummy Shale	490	550
Sandy Shale	550	582
Sand	582	605
Clay & Sand Streaks	605	692
Brown Shale	692	710
Gummy Shale	710	785
Sand	785	890
Clay	890	

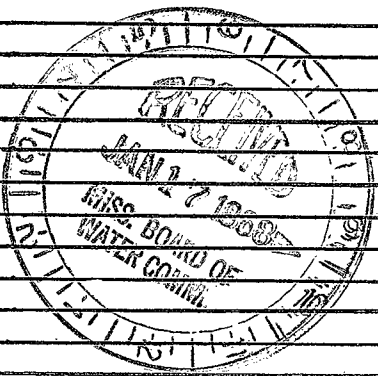

DRILLERS REMARKS:

If well telescopes please sketch and show depths.

GROUND LEVEL

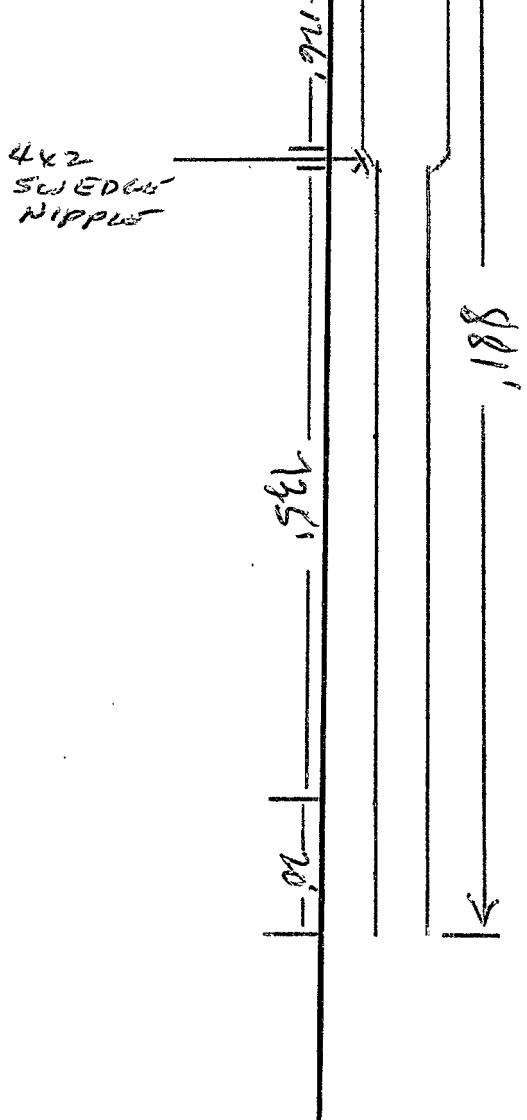


SECTION 3

Please indicate well location X.

ADDITIONAL INFORMATION

If more than one screen, show locations of each on sketch.