

Q36

2-22-57

WATER WELL DRILLERS LOG

4/11/65  
2319

Date: Feb. 22, 1957, Driller: Layne-Central Company County Washington

(Name)

(1) Owner of Land: Wade G. McCollum

(Name)

Hollandale, Mississippi

(Address)

(2) Location: 1/4, 1/4, Sec. 5 T R

7 miles east of Hollandale  
(distance) (direction) (Nearest Town)

(3) Topography: flat

(Hilly) (Flat) (Level)

(4) Purpose of Well: irrigation

(Domestic Irrigation  
Municipal, Industrial, Other)

Description & Color of Materials Sand, Clay, Red Clay, Shell, etc.	Thick- ness Feet	Depth Feet
Clay	26	26
Clay & fine sand	9	35
Coarse sand	31	66
Fine brown sand	6	72
Coarse sand & pea gravel	10	82
Sand & gravel	10	92
Sand & gravel	26	118

Information upon completion of well:

(1) Diameter 18x12 inches.

(2) Total Depth 118 feet.

(3) Water Level 20' - 4" feet below top of ground.

(4) Cased to 68', Size 18"  
2' swage

(5) Screen: Size 12", Length 50'

(6) Were any formations sealed against pollution?

no yes, no no.


If YES depth of formation \_\_\_\_\_

Why \_\_\_\_\_

Drillers Remarks: \_\_\_\_\_

2232 GPM

electric power

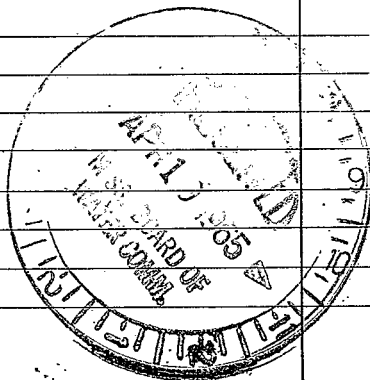

(Use Back Side)

Well No.

