

Washington
 Q39
 9-67

MISSISSIPPI
 BOARD OF WATER COMMISSIONERS
 416 North State Street
 Jackson, Mississippi 39201

WATER WELL DRILLERS LOG

9/13/19 67 Dyer Well & Irr. Ser. Washington
 date well completed firm name county well located

LANDOWNER: McLaurin Brothers

R. R. Hollandale

Mississippi

(mailing address)

WELL LOCATION:


sec. 22 T 15 N R 5 E
 S W
 0 miles N of Murphy
 (distance) (direction) (nearest town)

WELL PURPOSE: Home
 (home, irrigation, municipal, industrial)

WELL COMPLETION DATA:


- (1) diameter (inches) 4" x 2"
- (2) total depth (feet) 671 Ft.
- (3) static water level (feet) 12' below top of ground.
- (4) casing 4" Blk. 2" Galv. 651'
 (material) (depth)
 (size) if telescope see back.
- (5) screen 2" x 20 Ft. 651 Ft.
 (length) (depth to top)
 2" Stainless Steel
 (size) (material)
- (6) pump 1HP 25 GPM
 (HP) (yield gpm)
 (type power)
- (7) electric log No
 (yes or no)
 (organization running log)
- (8) how well bottom plugged Valve

description of formations encountered	from	to
Clay	0	18
Sand	18	48
Sand & Pea Gravel	48	123
Gravel & Sand	123	165
Clay & sand Streaks	255	340
Sand	340	418
Green sand & Clay St.	418	495
Shale	495	542
Sand	542	562
Gummy Shale	562	625
Sand	625	687
Clay	687	

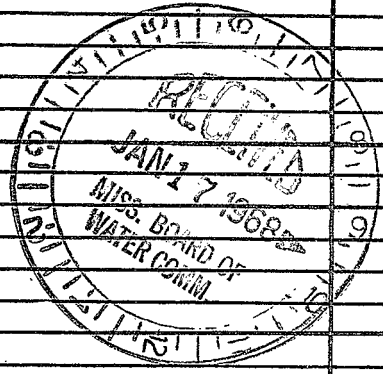

DRILLERS REMARKS:

If well telescopes please sketch and show depths.

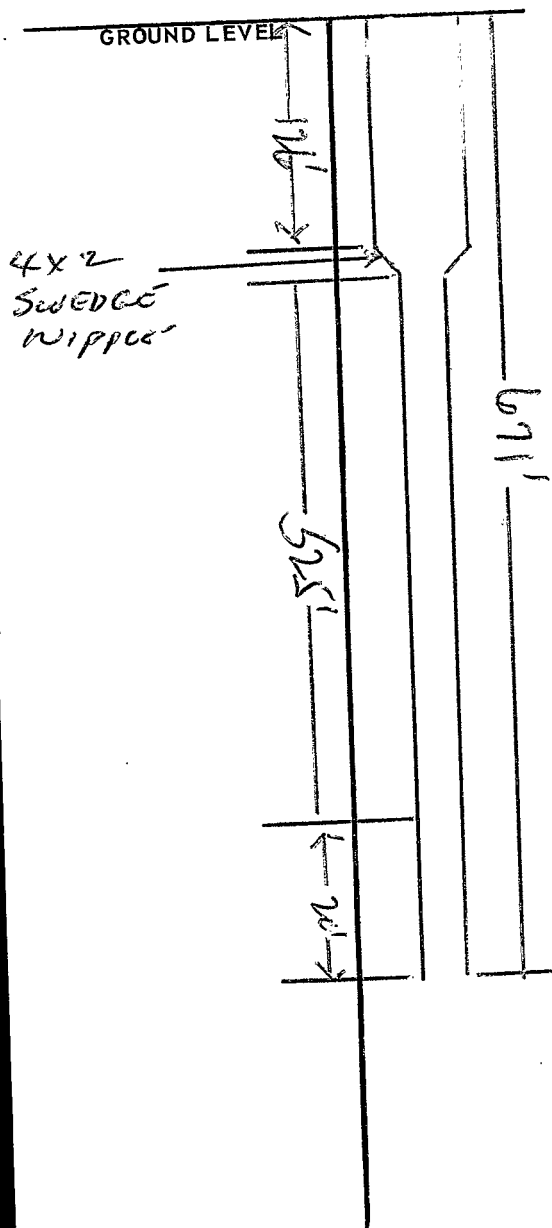

6			

SECTION 22

Please indicate well location X.

ADDITIONAL INFORMATION

If more than one screen, show locations of each on sketch.