

CODED

MISSISSIPPI
BOARD OF WATER COMMISSIONERS
416 North State Street
Jackson, Mississippi 39201

WATER WELL DRILLERS LOG

Washington
941
9-5-68

9-5 date well completed
1968 DUNE WELL IRP firm name
WASH. county well located

LANDOWNER: TORREY WOOD & SON

description of formations encountered

from to

HOLLANDALE,

CLAY

0 28

MISC

FINE BROWN SAND

28 33

(mailing address)

BLUE CLAY

33 38

WELL LOCATION:

FINE SAND

38 43

sec. 20 T. 15 N. R. 5 W.
2 1/2 miles N.W. of MURRAY
(distance) (direction) (nearest town)

BLUE CLAY

43 53

SHOT CLAY & SAND

53 63

MED SAND

63 73

COR SAND & GRA.

73 103

WELL PURPOSE: IRR.
(home, irrigation, municipal, industrial)

WELL COMPLETION DATA:

- (1) diameter (inches) 12"
- (2) total depth (feet) 103'
- (3) static water level (feet) 19' below above top of ground.
- (4) casing PUCON 63' (material) (depth)
12" (size) If telescope see back.
- (5) screen 40' 63' (length) (depth to top)
12" BLUE IR. (size) (material)
- (6) pump 30 1500 (HP) (yield gpm)
DIESEL (type power)
- (7) electric log NO (yes or no)

(organization running log)


(8) how well bottom plugged RATE

DRILLERS REMARKS:

2000
MISS. Bd. of
WATER COMMISSIONERS

If well telescopes please sketch and show depths.

GROUND LEVEL

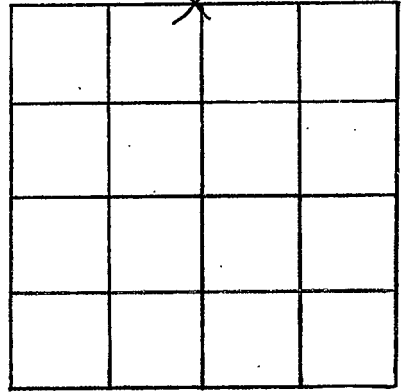

SECTION 70

Please indicate well location X.

ADDITIONAL INFORMATION

If more than one screen,
show locations of each on sketch.