

WASHINGTON
Q42
3-68

MISSISSIPPI
BOARD OF WATER COMMISSIONERS
416 North State Street
Jackson, Mississippi 39201

CODED

WATER WELL DRILLERS LOG

3-16 1968 Oyer Water Irr WASHINGTON
date well completed firm name county well located

LANDOWNER: MALIE J. NAVARRO
R.R.

description of formations encountered	from	to
CLAY	0	15
FINE SAND	15	24
COARSE BROWN SAND	24	53
PBA GRAVEL	53	63
L L	63	83
LARGE GRAVEL	83	93
E L L	93	103

HOLLANDALE, Miss.
(mailing address)


WELL LOCATION:
sec. 8 T. A N R. 5 X
7 miles EAST of HOLLANDALE
(distance) (direction) (nearest town)

WELL PURPOSE: IRRIGATION
(home, irrigation, municipal, industrial)

WELL COMPLETION DATA:


- (1) diameter (inches) 16"
- (2) total depth (feet) 103'
- (3) static water level (feet) 70' below top of ground.
- (4) casing BUR IRON 63'
(material) (depth)
16" if telescope see back.
(size)
- (5) screen 40' 63'
(length) (depth to top)
16" BUR IRON
(size) (material)
- (6) pump 60 6 3,000
(HP) (yield gpm)
DIESEL
(type power)
- (7) electric log N/D
(yes or no)
PLATE
(organization running log)
- (8) how well bottom plugged PLATE

DRILLERS REMARKS:

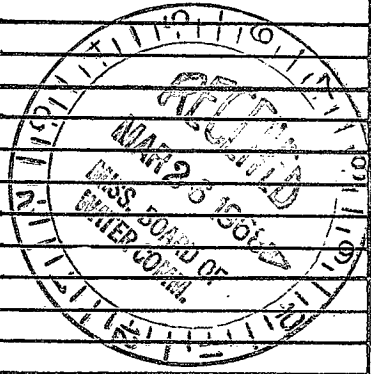

If well telescopes please sketch and show depths.

GROUND LEVEL

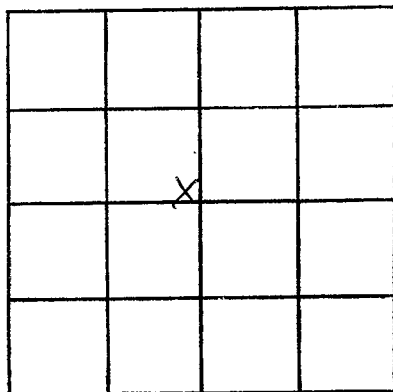

SECTION 8

Please indicate well location X.

ADDITIONAL INFORMATION

If more than one screen,
show locations of each on sketch.