

Washington

Q43

MISSISSIPPI BOARD OF WATER COMMISSIONERS

2-66

WATER WELL DRILLERS LOG

CODED Wash.

Date: 2-21, 1966, Driller: Bentley Bros W. B. Wood County Sevier

(Name)

(1) Owner of Land: B.C. PELANDUSAYE  
(Name)

CROWLEY, LA.

(Address)

(2) Location: SE 1/4, NE 1/4, Sec. 4 T. 15 R. 5W

8 miles S.E. of Houma, MISS.  
(distance) (direction) (Nearest Town)

(3) Topography: FLAT  
(Hilly) (Flat) (Level)

(4) Purpose of Well: IRRIGATION  
(Domestic Irrigation, Municipal, Industrial, Other)

Description & Color of Materials Sand, Clay, Red Clay, Shell, etc.	Thick- ness Feet	Depth Feet
<u>0-23 CLAY</u>	<u>23</u>	<u>23</u>
<u>33 COARSE SAND</u>	<u>10</u>	<u>33</u>
<u>43 FINE SAND</u>	<u>10</u>	<u>43</u>
<u>73 COARSE SAND</u>	<u>30</u>	<u>73</u>
<u>93 GRAVEL</u>	<u>20</u>	<u>93</u>
<u>103 GRAVEL</u>	<u>10</u>	<u>103</u>
<u>113 COARSE SAND &amp; SMALL GRAVEL</u>	<u>10</u>	<u>113</u>

Information upon completion of well:

- (1) Diameter 16 inches.
- (2) Total Depth 112 feet.
- (3) Water Level 16 feet below top of ground.
- (4) Cased to 82, Size 16
- (5) Screen: Size 16", Length 40
- (6) Were any formations sealed against pollution?  
no

CODED

yes, X no.

If YES depth of formation \_\_\_\_\_

Why \_\_\_\_\_


Drillers Remarks: \_\_\_\_\_

Yield in G. P. M.: 300

Type power: DIESEL

Crops irrigated & Acreage: 160 RICE

Insuff. info. to locate

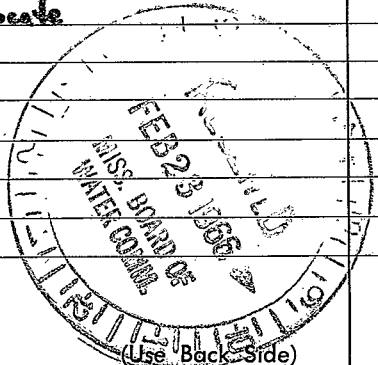

Well No.

