

Washington
 Q 50

MISSISSIPPI
 BOARD OF WATER COMMISSIONERS
 416 North State Street
 Jackson, Mississippi 39201

CODED

WATER WELL DRILLERS LOG
 DYER WELL & IRRIGATION SERVICE WASHINGTON

date well completed _____ 19 _____ firm name _____ county well located _____

LANDOWNER:
 DAVE JONES
 R.R. ISOLA
 (mailing address)

description of formations encountered	from to	
	feet	feet
CLAY	0	21
FINE SAND	21	33
COARSE SAND	33	44
SAND + GRAVEL	44	68

WELL LOCATION:
 sec. 11 T. 15 N. R. 5 E. W. W
9 1/2 miles EAST of HOLLANDALE
 (distance) (direction) (nearest town)

WELL PURPOSE: AGRI
 (home, irrigation, municipal, industrial)

- WELL COMPLETION DATA:
- (1) diameter (inches) 2"
 - (2) total depth (feet) 68'
 - (3) static water level (feet) 17 below above top of ground.
 - (4) casing 2" GALV 63'
 (material) (depth)
 - 2"
 (size) if telescope see back.
 - (5) screen 5' 63'
 (length) (depth to top)
 - 2" PLASTIC
 (size) (material)
 - (6) pump 1/2 10
 (HP) (yield gpm)
 - ELEC
 (type power)
 - (7) electric log NO
 (yes or no)
 - (organization running log) _____
 - (8) how well bottom plugged PLUG


CODED

DRILLERS REMARKS:

AUG 4 1970

If well telescopes please sketch and show depths.

GROUND LEVEL

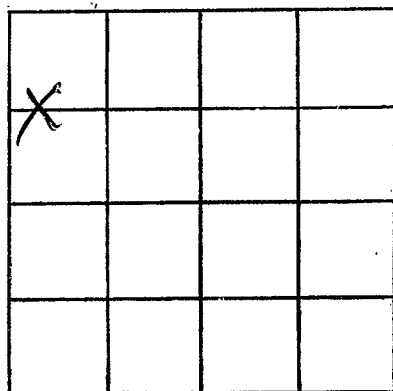

SECTION 11

Please indicate well location X.

ADDITIONAL INFORMATION

If more than one screen,
show locations of each on sketch.