

Washington
 Q 51
 3-9-70

MISSISSIPPI
 BOARD OF WATER COMMISSIONERS
 416 North State Street
 Jackson, Mississippi 39201

CODED

WATER WELL DRILLERS LOG

DYER WELL & IRRIGATION SERVICE

Washington
 Humphreys

3-9-70 19 date well completed firm name county well located

LANDOWNER:
 Greer Bros.
 Hollandale, Miss.
 (mailing address)

description of formations encountered	from	to
Clay	0	23
COARSE SAND	23	63
SAND + PEA GRAVEL	63	113

WELL LOCATION:
 sec. 8 T-15 N R-5 E
 4 miles NW of Morphy
 (distance) (direction) (nearest town)

WELL PURPOSE: IRR.
 (home, irrigation, municipal, industrial)

- WELL COMPLETION DATA:
- (1) diameter (inches) 16"
 - (2) total depth (feet) 113
 - (3) static water level (feet) 17 below top of ground.
 - (4) casing Steel 73 (material) (depth)
 16" If telescope see back. (size)
 - (5) screen 40' 73' (length) (depth to top).
 16" Steel (size) (material)
 - (6) pump 50 2500 (HP) (yield gpm)
 Elec. (type power)
 - (7) electric log No (yes or no)

CODED

(organization running log)
 (8) how well bottom plugged Plate


MAR 17 1970

DRILLERS REMARKS:

MISS. BD. OF
 WATER COMMISSIONERS

If well telescopes please sketch and show depths.

GROUND LEVEL

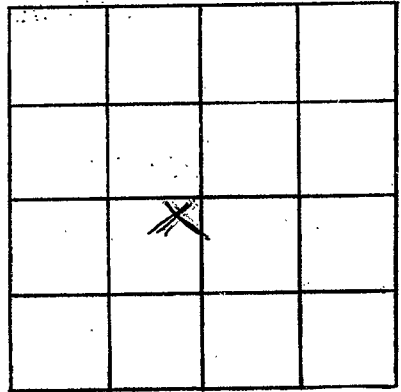

SECTION 8

Please indicate well location X.

ADDITIONAL INFORMATION

If more than one screen, show locations of each on sketch.