

Washington
 Q 52
 4-2-70

MISSISSIPPI
 BOARD OF WATER COMMISSIONERS
 416 North State Street
 Jackson, Mississippi 39201

CODED

WATER WELL DRILLERS LOG

DYER WELL & IRRIGATION SERVICE Washington

4-2-70 19 date well completed
 firm name
 county well located

LANDOWNER:
 MAXIE NAVARRE
 Hollandale MISS.
 (mailing address)

description of formations encountered	from	to
Clay	0	30
Sand + Gravel	30	73

WELL LOCATION:
 sec. 4 T. 15 N. R. 5
 7 1/2 miles E of Hollandale
 (distance) (direction) (nearest town)

WELL PURPOSE: Home
 (home, irrigation, municipal, industrial)

WELL COMPLETION DATA:

(1) diameter (inches) 2"
 (2) total depth (feet) 73'
 (3) static water level (feet) 17 below top of ground.
 (4) casing Steel, 63 (depth)
 2" (size) If telescope see back.
 (5) screen 10' length, 63 (depth to top)
 2" (size) PVC (material)
 (6) pump 1/2 (HP), 5 (yield gpm)
 Elec. (type power)
 (7) electric log ND (yes or no)
 (organization running log)

CODED


(8) how well bottom plugged
 DRILLERS REMARKS:

APR - 7 1970

MISS. BD. OF
 WATER COMM.

If well telescopes please sketch and show depths.

GROUND LEVEL

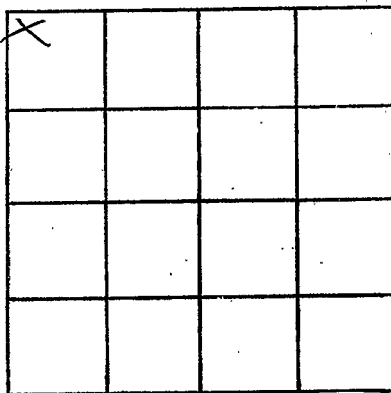

SECTION 4

Please indicate well location X.

ADDITIONAL INFORMATION

If more than one screen,
show locations of each on sketch.