

WASHINGTON  
Q53  
4-10-72

MISSISSIPPI  
BOARD OF WATER COMMISSIONERS  
416 North State Street  
Jackson, Mississippi 39201

CODED

WATER WELL DRILLERS LOG

C14510-3769

April 10, 1972 Singer-Layne Central Division Washington  
date well completed firm name county well located

LANDOWNER: Fontenot & Fontenot	description of formations encountered	from	to
Hollandale, Mississippi	Clay	0	17
	Fine sand	17	30
	Coarse sand, gravel	30	90
(mailing address)	Gravel	90	102
WELL LOCATION:	Fine sand	102	104
sec. 28 T 15 N R 5 E W			
8 miles SE of Hollandale			
(distance) (direction) (nearest town)			
WELL PURPOSE: irrigation			
(home, irrigation, municipal, industrial)			
WELL COMPLETION DATA:			
(1) diameter (inches) 12			
(2) total depth (feet) 102			
(3) static water level (feet) 20' below top of ground.			
(4) casing steel, 62', (material) (depth)			
12" (size) if telescope see back.			
(5) screen 40', 102' (length) (depth to top)			
12", Armco (size) (material)			
(6) pump 25 HP, 1500 (HP) (yield gpm)			
electric (type power)			
(7) electric log no (yes or no)			
(organization running log)			
(8) how well bottom plugged plate			
DRILLERS REMARKS:			


CODED

MAY 16 1972

MISS. DEPT. OF AGRICULTURE  
WATER DIVISION

If well telescopes please sketch and show depths.

GROUND LEVEL

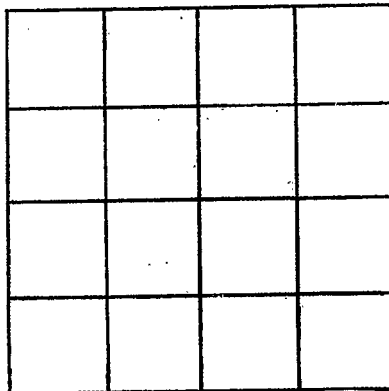

SECTION \_\_\_\_\_

Please indicate well location X.

ADDITIONAL INFORMATION

If more than one screen, show locations of each on sketch.