

WASH.
Q56
7-26-73

MISSISSIPPI
BOARD OF WATER COMMISSIONERS
416 North State Street
Jackson, Mississippi 39201

WATER WELL DRILLERS LOG
DYER WELL & IRRIGATION SERVICE

CODED

WASHINGTON

7-26-1973
date well completed

firm name

county well located

LANDOWNER: Anthony Frey

description of formations encountered

from to

HOLLANDALE,

Clay
Fine Sand
Sand Gravel

0 18
18 30
30 113

Miss.

(mailing address)

WELL LOCATION:

sec. 29 T-15 N R-5 E
2 1/2 miles W of MURRAY
(distance) (direction) (nearest town)

WELL PURPOSE:

(home, irrigation, municipal, industrial)

WELL COMPLETION DATA:

- (1) diameter (inches) 16"
- (2) total depth (feet) 113'
- (3) static water level (feet) 1.8' below above top of ground.
- (4) casing BUENA, 73' (material), (depth), 16" (size) if telescope see back.
- (5) screen 40' 73' (length), (depth to top), 16" BUENA (size), (material)
- (6) pump 50 2250 (HP), (yield gpm), DIESEL (type power)
- (7) electric log No (yes or no)

CODED

(organization running log)

(8) how well bottom plugged RATE

DRILLERS REMARKS:


OCT 25 1973

MISS. Bd. of

WATER COMMISSIONERS

If well telescopes please sketch and show depths.

GROUND LEVEL

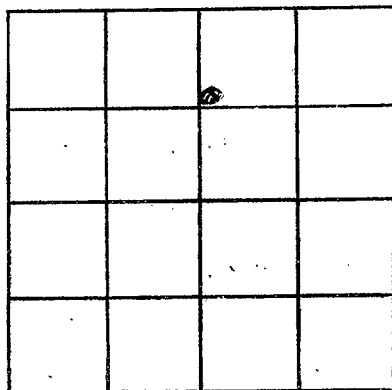

SECTION 29

Please indicate well location X.

ADDITIONAL INFORMATION

If more than one screen,
show locations of each on sketch.