

Washington
Q 600
6-6-75

MISSISSIPPI
BOARD OF WATER COMMISSIONERS
416 North State Street
Jackson, Mississippi 39201

CODED

WATER WELL DRILLERS LOG


June 6, 19 75 date well completed
Singer - Payne Frey Farms, Inc. firm name
Washington county well located

LANDOWNER: Frey Farms, Inc. Hollandale, Mississippi (mailing address)	description of formations encountered	from	to
	Coarse Sand	18	42'
	Gravel	42	62'
	Coarse sand & gravel	62	112'
WELL LOCATION: 15 H sec. 18 T 15 N R 5 E X W 8 miles East of Hollandale (distance) (direction) (nearest town)			
WELL PURPOSE: irrigation (home, irrigation, municipal, industrial)			
WELL COMPLETION DATA:			
(1) diameter (inches) 30"			
(2) total depth (feet) 112'			
(3) static water level (feet) 13 below top of ground.			
(4) casing Steel 62' (material) (depth) 16" (size) if telescope see back.			
(5) screen 50' 50' (length) (depth to top) 16" Steel (size) (material)			
(6) pump 60 2500 (HP) (yield gpm) engine (type power)			
(7) electric log no (yes or no) (organization running log)			
(8) how well bottom plugged steel plate			
DRILLERS REMARKS:			

RECEIVED
JUL 14 1975

If well telescopes please sketch and show depths.

GROUND LEVEL

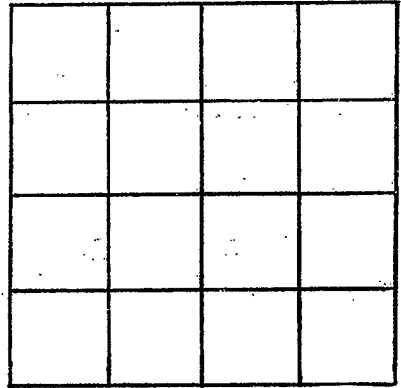

SECTION _____

Please indicate well location X.

ADDITIONAL INFORMATION

If more than one screen, show locations of each on sketch.