

WASHINGTON
 CL-3140
 Q66

MISSISSIPPI DEPARTMENT OF NATURAL RESOURCES
 Bureau of Land and Water Resources
 Southport Mall
 P.O. Box 10631
 Jackson, Mississippi 39209
 WATER WELL DRILLERS LOG

CODED

9-20 19 85 LAYNE CENTRAL CO. WASHINGTON
 date well completed firm name county well located

LANDOWNER:	description of formations encountered	from	to
WILLETTE PLANTATION	clay	0	12
HOLLANDALE, MS	sand	12	35
(mailing address)	clay	35	38
	coarse sand	38	60
WELL LOCATION:	sand gravel	60	116
sec. 19 T 15 N R 5 E	gravel	116	123
8 miles ESE Hollandale			
(distance) (direction) (nearest town)			

WELL LOCATION:
 sec. 19 T 15 N R 5 E
 8 miles ESE Hollandale
 (distance) (direction) (nearest town)

WELL PURPOSE: irrigation
 (home, irrigation, municipal, industrial)

WELL COMPLETION DATA:

(1) diameter (inches) 32"

(2) total depth (feet) 122'

(3) static water level (feet) 20' below top of ground.

(4) casing steel 70'
 (material) (depth)
 16" if telescope see back.
 (size)

(5) screen 50' 70'
 (length) (depth to top)
 16" st. steel
 (size) (material)

(6) pump 60 2500
 (HP) (yield gpm)
 elec.
 (type power)

(7) electric log no
 (yes or no)
 (organization running log)

(8) how well bottom plugged st. plate


DRILLERS REMARKS:

RECEIVED
 NOV 14 1985

Department of Natural Resources
 Bureau of Land & Water Resources

If well telescopes please
sketch and show depths.

GROUND LEVEL

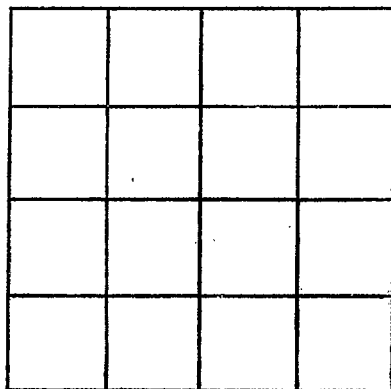

SECTION _____

Please indicate well location X.

ADDITIONAL INFORMATION

If more than one screen,
show locations of each on sketch.