

MISSISSIPPI DEPARTMENT OF NATURAL RESOURCES

Bureau of Land and Water Resources

Southport Mall

P.O. Box 10631

Jackson, Mississippi 39209

WATER WELL DRILLERS LOG

WASHINGTON
Q 67
1-13-86

CODED

Jan 13 1986 Larry's wells pump Washington
 date well completed firm name county well located

LANDOWNER:	description of formations encountered	from	to
<u>Ray Barger</u>			
<u>Greenwood mo</u> (mailing address)	<u>clay</u>	<u>0</u>	<u>30</u>
	<u>Fast S.Gnd</u>	<u>30</u>	<u>50</u>
	<u>coarse sand & gravel</u>	<u>50</u>	<u>102</u>
WELL LOCATION: sec <u>9</u> T <u>15</u> N R <u>5</u> E <u>3</u> N miles <u>1</u> W of <u>Murphy</u> (distance) (direction) (nearest town)			
WELL PURPOSE: (home, irrigation, municipal, industrial)			
WELL COMPLETION DATA: (1) diameter (inches) <u>12"</u> (2) total depth (feet) <u>102'</u> (3) static water level (feet) <u>22</u> <input type="checkbox"/> below <input type="checkbox"/> above top of ground. (4) casing <u>steel</u> , <u>62</u> , (material) (depth) ____ if telescope see back. (size) (5) screen <u>1/2"</u> , <u>62'</u> (length) (depth to top) <u>12"</u> , <u>steel</u> (size) (material) (6) pump <u>80</u> <u>1200</u> (HP) (yield gpm) <u>1</u> (type power) (7) electric log <u>NO</u> (yes or no) ____ (organization running log) (8) how well bottom plugged <u>Steel</u> <u>Plate</u>			
DRILLERS REMARKS:			


CODED

RECEIVED
 OCT 01 1986

Department of Natural Resources
 Bureau of Land and Water Resources

If well telescopes please sketch and show depths.

GROUND LEVEL

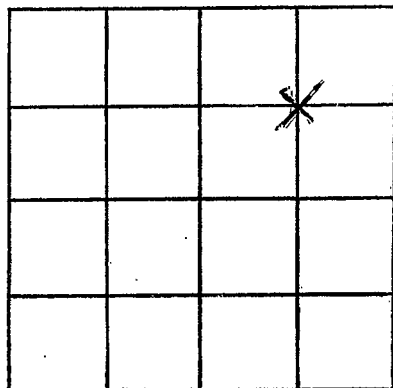

SECTION 9

Please indicate well location X.

ADDITIONAL INFORMATION

If more than one screen,
show locations of each on sketch.