

WASH  
Q 84  
5-10-76

MISSISSIPPI  
BOARD OF WATER COMMISSIONERS  
416 North State Street  
Jackson, Mississippi 39201

WATER WELL DRILLERS LOG

WASHINGTON  
~~Washington~~  
county well located

5-10 date well completed 1976 Dyer-Sullivan firm name

LANDOWNER: Antony Frey  
Belzoni, Miss

description of formations encountered	from	to
	0	21
SAND - GRAVEL	21	119

(mailing address)

WELL LOCATION:

sec. 33 T. 15 S. R. 5 E.  
2 miles 411 of Murphy  
(distance) (direction) (nearest town)

WELL PURPOSE: IRRIGATION  
(home, irrigation, municipal, industrial)

WELL COMPLETION DATA:

- (1) diameter (inches) 16"
- (2) total depth (feet) 119'
- (3) static water level (feet) 19' below top of ground.
- (4) casing (material) Steel, (depth) 89'
- (5) screen (size) 16" if telescope see back. (length) 40', (depth to top) 89'
- (6) pump (size) 16" (material) Steel (HP) 60 (yield gpm) 2700 (type power) Diesel
- (7) electric log (yes or no) NO
- (organization running log)
- (8) how well bottom plugged PLATE


RECEIVED  
JUL - 9 1976

DRILLERS REMARKS:

MISS. BD. OF WATER COMMISSIONERS

If well telescopes please sketch and show depths.

GROUND LEVEL

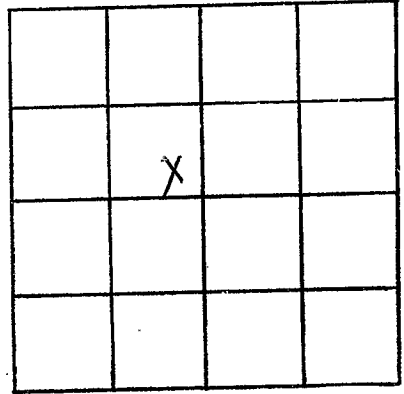

SECTION \_\_\_\_\_

Please indicate well location X.

ADDITIONAL INFORMATION

If more than one screen,  
show locations of each on sketch.