

WASHINGTON

CL-1065 986

3-19-79

MISSISSIPPI BOARD OF WATER COMMISSIONERS
416 North State Street
Jackson, Mississippi 39201

CODED

WATER WELL DRILLERS LOG

3-19-79
date well completed

19 79 LAYNE CENTRAL CO.
firm name

WASHINGTON
county well located

LANDOWNER:	description of formations encountered	from	to
D & W JONES			
HOLLANDALE, MS (mailing address)	Coarse Sand	30	35
	Coarse Sand & Pea Gravel	35	70
	Coarse Sand - Gravel	70	117
	Fine Sand	117	119
WELL LOCATION:			
sec. 10 T 15 N R 5 E W			
8 miles East of Hollandale (distance) (direction) (nearest town)			
WELL PURPOSE: Irrigation (home, irrigation, municipal, industrial)			
WELL COMPLETION DATA:			
(1) diameter (inches) 16"			
(2) total depth (feet) 117'			
(3) static water level (feet) 25 below top of ground			
(4) casing Steel 67' (material) (depth)			
16" if telescope see back. (size)			
(5) screen 50' 67' (length) (depth to top)			
16" St. Steel (size) (material)			
(6) pump 50 2400 (HP) (yield gpm)			
Diesel (type power)			
(7) electric log No (yes or no)			
(organization running log)			
(8) how well bottom plugged St. Plate			
DRILLERS REMARKS:			

CODED


Miss. Board of Water Comm.

SEP 12 1979

RECEIVED

If well telescopes please sketch and show depths.

GROUND LEVEL

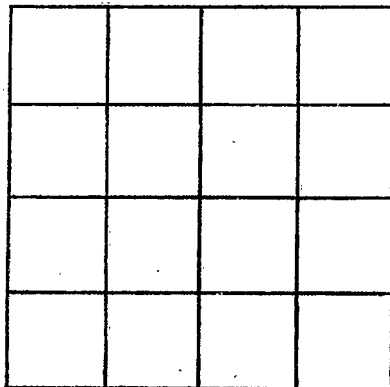

SECTION _____

Please indicate well location X.

ADDITIONAL INFORMATION

If more than one screen, show locations of each on sketch.