

WASHINGTON
 Q 88
 4-13-81


MISSISSIPPI
 BOARD OF WATER COMMISSIONERS
 416 North State Street
 Jackson, Mississippi 39201

CODED

WATER WELL DRILLERS LOG


4-13 date well completed 1981 Irrigation Well Supply Wash firm name Wash county well located

LANDOWNER:	description of formations encountered	from	to
WELL LOCATION:			
W. J. HUNTER P.O. BOX 275 ROLLINGFORK, MS 39159 (mailing address)	CLAY	0	30
	SAND	30	40
	"	40	50
	"	50	60
	"	60	70
	"	70	80
12 mi. miles SE of Natchez (distance) (direction) (nearest town)	SAND & GRAVEL	80	90
	"	90	100
	"	100	110
WELL PURPOSE: (home, irrigation, municipal, industrial)	"	110	120
	"	120	130
WELL COMPLETION DATA:			
(1) diameter (inches) 16"			
(2) total depth (feet) 130'			
(3) static water level (feet) 20' below top of ground.			
(4) casing STEEL 82' (material) (depth)			
16" If telescope see back. (size)			
(5) screen 48' 82' (length) (depth to top)			
16" METAL (size) (material)			
(6) pump 10 3000 (HP) (yield gpm)			
DIESEL (type power)			
(7) electric log No (yes or no)			
(organization running log)			
(8) how well bottom plugged PLACE WELDED TO SCREEN			
DRILLERS REMARKS:			

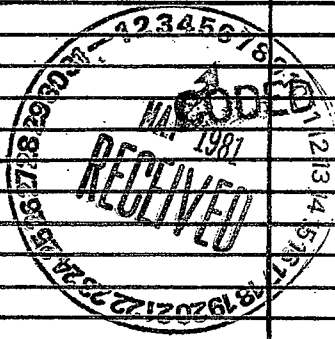

If well telescopes please sketch and show depths.

GROUND LEVEL

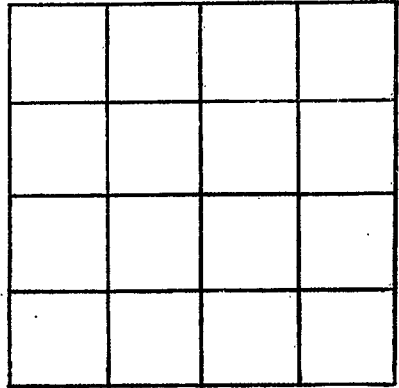

SECTION _____

Please indicate well location X.

ADDITIONAL INFORMATION

If more than one screen, show locations of each on sketch.