

MISSISSIPPI DEPARTMENT OF NATURAL RESOURCES
Bureau of Land and Water Resources
 Southport Mall
 P.O. Box 10631
 Jackson, Mississippi 39209
WATER WELL DRILLERS LOG

CODED

WASHINGTON
Q89
8-27-80

08/27 1980 Larry's Well & Pump Washington
 date well completed firm name county well located

LANDOWNER: Leroy Frey
 Belzoni MS,
 (mailing address)

description of formations encountered	from	to
slay	0	2.5
fine sand	2.5	3.5
med sand	3.5	6.0
coarse sand & gravel	6.0	11.8'

WELL LOCATION:
 sec. 4 T. 15 N. R. 5 W.
 9 miles E of Hollandale
 (distance) (direction) (nearest town)

WELL PURPOSE: Fish Pond
 (home, irrigation, municipal, industrial)

- WELL COMPLETION DATA:
- (1) diameter (inches) 16"
 - (2) total depth (feet) 118'
 - (3) static water level (feet) 21' below above top of ground.
 - (4) casing Steel 78' (material) (depth)
 - (size) if telescope see back.
 - (5) screen 40' 78' (length) (depth to top)
 - 16" steel (size) (material)
 - (6) pump 60 3000 (HP) (yield gpm)
 - (type power)
 - (7) electric log No (yes or no)
 - (organization running log)
 - (8) how well bottom plugged Steel plate

CODED

DEPT. OF NATURAL RESOURCES
 BUREAU OF LAND & WATER RESOURCES


MAY 18 1981

RECEIVED

DRILLERS REMARKS:

If well telescopes please sketch and show depths.

GROUND LEVEL

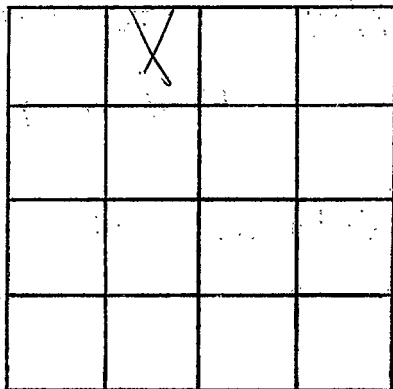

SECTION 4

Please indicate well location X.

ADDITIONAL INFORMATION

If more than one screen,
show locations of each on sketch.