

MISSISSIPPI DEPARTMENT OF NATURAL RESOURCES

Bureau of Land and Water Resources

Southport Mall

P.O. Box 10631

Jackson, Mississippi 39209

WATER WELL DRILLERS LOG

Washington

Washington

Q 90

5-4-81

5/4/81
date well completed

Joe McLawrin
firm name

Stumphey
county well located

LANDOWNER: *Joe McLawrin*

description of formation encountered **CODED** from to

Hollandale, Miss.
(mailing address)

<i>Clay</i>	<i>0</i>	<i>18</i>
<i>Fine Sand</i>	<i>18</i>	<i>28</i>
<i>Sand</i>	<i>28</i>	<i>46</i>
<i>Sand & Gravel</i>	<i>46</i>	<i>113</i>

WELL LOCATION:


sec. *21* T. *15* N. R. *5* E
10 miles *East* of *Hollandale*
 (distance) (direction) (nearest town)

WELL PURPOSE: *Irrigation*
 (home, irrigation, municipal, industrial)

WELL COMPLETION DATA:

- (1) diameter (inches) *16*
- (2) total depth (feet) *113*
- (3) static water level (feet) *23* below above top of ground.
- (4) casing *Steel* *73'*
 (material) (depth)
- 16"* If telescope see back.
 (size)
- (5) screen *40'* *73'*
 (length) (depth to top)
- 16"* *Steel*
 (size) (material)
- (6) pump *Lee* *3000*
 (HP) (yield gpm)
- Fluorac*
 (type power)
- (7) electric log *No*
 (yes or no)

CODED

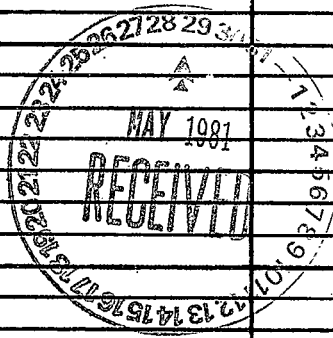


(organization running log)

(8) how well bottom plugged *Plate*

DRILLERS REMARKS:

If well telescopes please sketch and show depths.

GROUND LEVEL

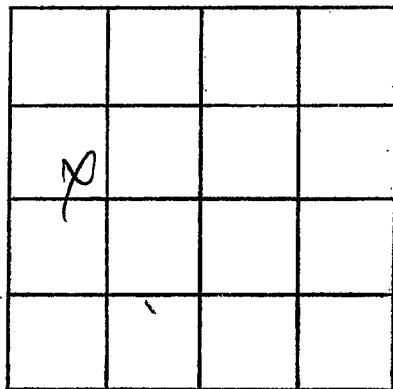

SECTION 11

Please indicate well location X.

ADDITIONAL INFORMATION

If more than one screen, show locations of each on sketch.