

WASHINGTON
Q91
3-20-81

MISSISSIPPI
BOARD OF WATER COMMISSIONERS
416 North State Street
Jackson, Mississippi 39201

CODED

WATER WELL DRILLERS LOG

March 20 19 81 Bruce Berryman - Washington
date well completed firm name county well located
Greenwood.

LANDOWNER: Mr. Gerald Pake
Rt. 2. Box 75
Hollandale MS 38748
(mailing address)

WELL LOCATION:
sec. 32 T 15 N R E
S S W
3 miles S.E. of HOLLANDALE
(distance) (direction) (nearest town)


WELL PURPOSE: Home
(home, irrigation, municipal, industrial)

WELL COMPLETION DATA:

- (1) diameter (inches) 4" x 2 1/2"
- (2) total depth (feet) 500'
- (3) static water level (feet) 18 below top of ground. 4" blk - 168'
- (4) casing 2 1/2" blk - 302' (material) (depth)
- (size) if telescope see back.
- (5) screen 30' length, 470 ft. depth to top. 2 1/2" .010 Stainless steel (size) (material)
- (6) pump 5 h.p. 60 (HP) (yield gpm)
Electric (type power)
- (7) electric log NO (yes or no)
(organization running log)
- (8) how well bottom plugged B.P.V.

description of formations encountered	from	to
Clay	0	20
Sand	20	80
Sand & gravel	80	150
Clay	150	180
Sand	180	250
Shale	250	290
Sand	290	390
Clay	390	400
Sand	400	410
Shale	410	440
Fine sand	440	500
Shale	500	530
Sand	530	540
Clay	540	550


CODED

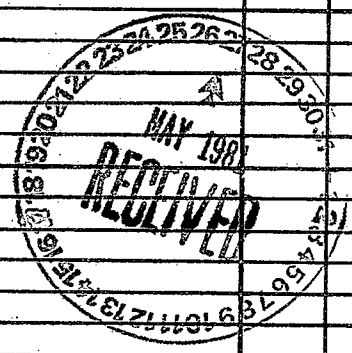

DRILLERS REMARKS:

If well telescopes please sketch and show depths.

GROUND LEVEL

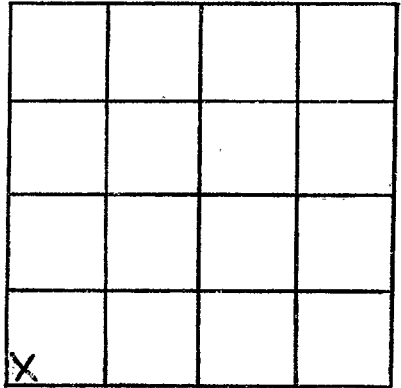

SECTION 32

Please indicate well location X.

ADDITIONAL INFORMATION

If more than one screen, show locations of each on sketch.