

MISSISSIPPI DEPARTMENT OF NATURAL RESOURCES

Bureau of Land and Water Resources

Southport Mall

P.O. Box 10631

Jackson, Mississippi 39209

WATER WELL DRILLERS LOG

Washington  
Q192  
4-29-81

April 29 19 81 Lenny's well & pump Washington  
date well completed firm name county well located


LANDOWNER: Frey, Frey & Frey	description of formations encountered	CODED	from	to
Hollandale ms (mailing address)	CLAY		0	50
	FINE SAND		50	75
	COURSE SAND		75	116

WELL LOCATION:  
sec. 3 T. 15 N. R. 5 W.  
10 miles E of Hollandale  
(distance) (direction) (nearest town)

WELL PURPOSE:  
(home, irrigation, municipal, industrial)


- WELL COMPLETION DATA:
- (1) diameter (inches) 16"
  - (2) total depth (feet) 116'
  - (3) static water level (feet) 21 below above top of ground.
  - (4) casing Steel, 76' (material) (depth)  
(size) If telescope see back.
  - (5) screen 40', 76' (length) (depth to top)  
16" Steel (size) (material)
  - (6) pump (HP) (yield gpm)  
(type power)
  - (7) electric log NO (yes or no)  
(organization running log)
  - (8) how well bottom plugged Steel Plate.

DRILLERS REMARKS:

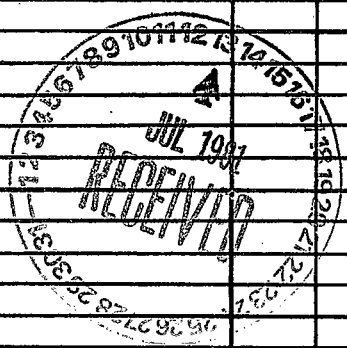

If well telescopes please sketch and show depths.

GROUND LEVEL

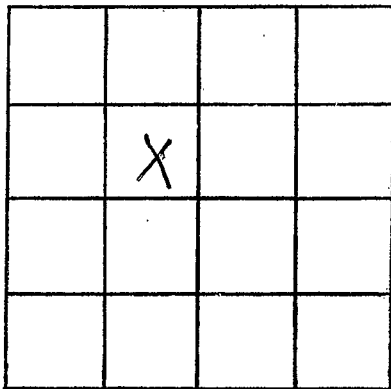

SECTION 3

Please indicate well location X.

ADDITIONAL INFORMATION

If more than one screen, show locations of each on sketch.