

MISSISSIPPI DEPARTMENT OF NATURAL RESOURCES

Bureau of Land and Water Resources

Southport Mall

P.O. Box 10631

Jackson, Mississippi 39209


WATER WELL DRILLERS LOG

Wash
Q 93
3-27-81

March 27, 1981 Larry Wells pump Washington
date well completed firm name county well located

LANDOWNER: <u>Frey Farms</u>	description of formation encountered	CODED	from	to
<u>Hollandale, MS.</u> (mailing address)	<u>CLAY</u>		<u>0</u>	<u>50</u>
	<u>FINE SAND</u>		<u>50</u>	<u>80</u>
	<u>MED COARSE SAND</u>		<u>80</u>	<u>123</u>
WELL LOCATION:				
sec. <u>3</u> T. <u>15</u> N. R. <u>5</u> W.				
<u>11</u> miles <u>E</u> of <u>Hollandale</u>				
(distance) (direction) (nearest town)				
WELL PURPOSE: (home, irrigation, municipal, industrial)				
WELL COMPLETION DATA:				
(1) diameter (inches) <u>16"</u>				
(2) total depth (feet) <u>123'</u>				
(3) static water level (feet) <u>92</u> below top of ground				
(4) casing <u>Steel</u> , <u>83'</u> (material) (depth)				
(size) If telescope see back.				
(5) screen <u>40'</u> , <u>83'</u> (length) (depth to top)				
<u>16"</u> , <u>Steel</u> (size) (material)				
(6) pump _____ (HP) _____ (yield gpm)				
(type power)				
(7) electric log <u>No</u> (yes or no)				
(organization running log)				
(8) how well bottom plugged <u>Steel Plate</u>				
DRILLERS REMARKS:				

CODED

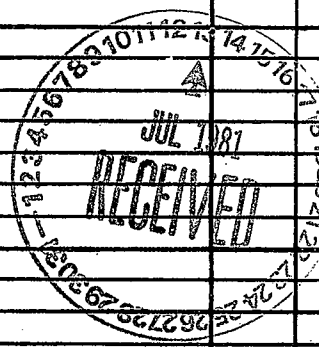

If well telescopes please sketch and show depths.

GROUND LEVEL

		X	

SECTION 3

Please indicate well location X.

ADDITIONAL INFORMATION

If more than one screen, show locations of each on sketch.