

MISSISSIPPI DEPARTMENT OF NATURAL RESOURCES
Bureau of Land and Water Resources
 Southport Mall
 P.O. Box 10631
 Jackson, Mississippi 39209
WATER WELL DRILLERS LOG

Washington
 CL-2418 *Q97*
4/15/82

CODED

CODED

4-15 1982 LAYNE CENTRAL CO. WASHINGTON
 date well completed firm name county well located

LANDOWNER:	description of formations encountered	from	to
WILLETT PLANTATION			
HOLLANDALE, MS	caly.	22	49
(mailing address)	c. sand & pea gravel	49	52
	" " " "	52	72
WELL LOCATION:	" " " "	72	82
sec. 19 T. 15 N R. 5 W	c. sand & gravel	82	92
	" " " "	92	122
_____ miles _____ of _____ (distance) (direction) (nearest town)			

WELL PURPOSE:
 (home, irrigation, municipal, industrial)

- WELL COMPLETION DATA:**
- (1) diameter (inches) 32"
 - (2) total depth (feet) 122'
 - (3) static water level (feet) 26' ~~below~~ ^{above} top of ground.
 - (4) casing steel 71' 72'
 (material) (depth)
16" if telescope see back.
 (size)
 - (5) screen 50' 72' 71'
 (length) (depth to top)
16" st. steel
 (size) (material)
 - (6) pump 60 2500
 (HP) (yield gpm)
electric
 (type power)
 - (7) electric log no
 (yes or no)

 (organization running log)
 - (8) how well bottom plugged st. plate

CODED

DEPT. OF NATURAL RESOURCES
 BUREAU OF LAND & WATER RESOURCES


JUN 24 1982

RECEIVED

DRILLERS REMARKS:

If well telescopes please sketch and show depths.

GROUND LEVEL

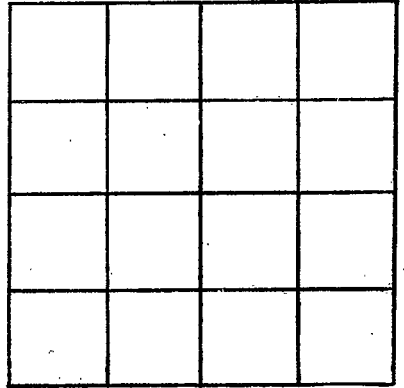

SECTION _____

Please indicate well location X.

ADDITIONAL INFORMATION

If more than one screen, show locations of each on sketch.