

MISSISSIPPI DEPARTMENT OF NATURAL RESOURCES

Bureau of Land and Water Resources

Southport Mall

P.O. Box 10631

Jackson, Mississippi 39209

WATER WELL DRILLERS LOG

CODED

Q99  
5-5-83

May 05 1983  
date well completed

Larry's Well Pump  
firm name

Washington  
county well located

LANDOWNER: <u>Billy Hunter</u>	description of formations encountered	from	to
<u>Hollandale, ms</u> (mailing address)	<u>slay</u>	<u>0</u>	<u>150</u>
	<u>Stand</u>	<u>60</u>	<u>70</u>
	<u>Sand to gravel</u>	<u>76</u>	<u>120</u>
<b>WELL LOCATION:</b>			
sec. <u>27</u> T. <u>15</u> N R. <u>3</u> E S S W			
<u>1</u> miles <u>South</u> of <u>Murphy</u> (distance) (direction) (nearest town)			
<b>WELL PURPOSE:</b> <u>Rish Pond</u> (home, irrigation, municipal, industrial)			
<b>WELL COMPLETION DATA:</b>			
(1) diameter (inches) <u>10"</u>			
(2) total depth (feet) <u>120'</u>			
(3) static water level (feet) <u>24</u> below above top of ground.			
(4) casing <u>Pvc</u> <u>80'</u> (material) (depth)			
(size) If telescope see back.			
(5) screen <u>40'</u> <u>80'</u> (length) (depth to top)			
<u>10"</u> <u>Pvc</u> (size) (material)			
(6) pump <u>20</u> <u>1100</u> (HP) (yield gpm)			
(type power)			
(7) electric log <u>No</u> (yes or no)			
(organization running log)			
(8) how well bottom plugged <u>Pvc cap</u>			
DRILLERS REMARKS:			


CODED

DEPT. OF NATURAL RESOURCES  
BUREAU OF LAND & WATER RESOURCES

SEP 26 1983  
RECEIVED

If well telescopes please sketch and show depths.

GROUND LEVEL

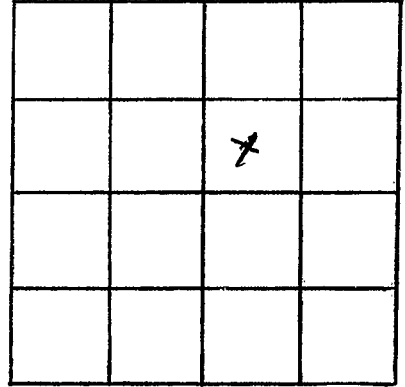

SECTION 27

Please indicate well location X.

ADDITIONAL INFORMATION

If more than one screen,  
show locations of each on sketch.