

MISSISSIPPI DEPARTMENT OF NATURAL RESOURCES

Bureau of Land and Water Resources

Southport Mall

P.O. Box 10631

Jackson, Mississippi 39209

WATER WELL DRILLERS LOG

CODED

Q100

May 05 1983  
date well completed

Lewis well & pump  
w well name

Washington Co  
county well located

LANDOWNER:	description of formations encountered	from	to
Ray Berger	slay	0	30
Greenwood ms. (mailing address)	Steel	30	60
	Sand & gravel	60	116
			1
<b>WELL LOCATION:</b> sec. 9 T 15 N R 5 E S 5 W 2 miles North of Murphy (distance) (direction) (nearest town)			
<b>WELL PURPOSE:</b> (home, irrigation, municipal, industrial)			
<b>WELL COMPLETION DATA:</b>			
(1) diameter (inches) 16"			
(2) total depth (feet) 116'			
(3) static water level (feet) 24 below top of ground.			
(4) casing Steel 76' (material) (depth)			
(size) If telescope see back.			
(5) screen 40' 76' (length) (depth to top)			
16" Steel (size) (material)			
(6) pump 60 3000 (HP) (yield gpm)			
0 (type power)			
(7) electric log No (yes or no)			
(organization running log)			
(8) how well bottom plugged Steel Plate			

CODED


MISSISSIPPI DEPARTMENT OF NATURAL RESOURCES  
BUREAU OF LAND & WATER RESOURCES

SEP 28 1983  
RECEIVED

DRILLERS REMARKS:

If well telescopes please sketch and show depths.

GROUND LEVEL

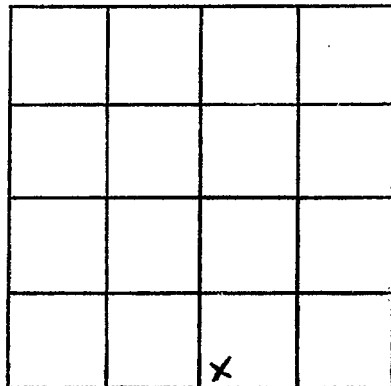

SECTION 9

Please indicate well location X.

ADDITIONAL INFORMATION

If more than one screen, show locations of each on sketch.