

MISSISSIPPI DEPARTMENT OF NATURAL RESOURCES

Bureau of Land and Water Resources

Southport Mall

P.O. Box 10631

Jackson, Mississippi 39209

**CODED**

**WATER WELL DRILLERS LOG**  
**BUTANE GAS COMPANY**

Q 103  
WASHINGTON  
6-25-84

6-25 19 84  
date well completed

OF GREENWOOD  
firm name

Washington  
county well located

LANDOWNER: # 2  
Con Agra  
Hollandale Mo.  
(mailing address)

description of formations encountered	from	to
Clay	0	32
fine sand	32	78
sand & gravel	78	90
gravel	90	115

WELL LOCATION:  
sec. 17 T. 15N R. 5 E  
S SE W  
6 miles SE of Hollandale.  
(distance) (direction) (nearest town)

WELL PURPOSE:  
(home, irrigation, municipal, industrial)

- WELL COMPLETION DATA:
- (1) diameter (inches) 16"
  - (2) total depth (feet) 115
  - (3) static water level (feet) 30 below top of ground.
  - (4) casing Steel, 75 (material), (depth)  
16" (size) if telescope see back.
  - (5) screen 40, 75 (length), (depth to top)  
16" (size), Steel (material)
  - (6) pump 60, 2500 (HP), (yield gpm)  
Start Diesel (type power)
  - (7) electric log No (yes or no)  
No (organization running log)
  - (8) how well bottom plugged Steel plate

DEPT. OF NATURAL RESOURCES  
BUREAU OF LAND & WATER RESOURCES


JUL 24 1984

**RECEIVED**

DRILLERS REMARKS:  
Richard Vest

If well telescopes please sketch and show depths.

GROUND LEVEL

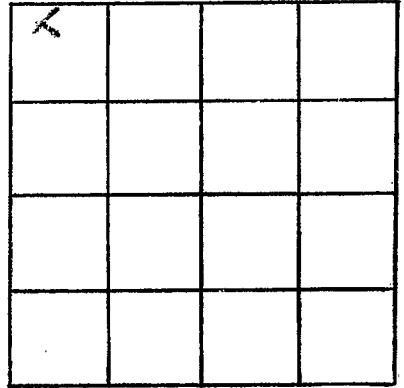

SECTION 17

Please indicate well location X.

ADDITIONAL INFORMATION

If more than one screen,  
show locations of each on sketch.