

**MISSISSIPPI DEPARTMENT OF NATURAL RESOURCES**  
**Bureau of Land and Water Resources**  
 Southport Mall  
 P.O. Box 10631  
 Jackson, Mississippi 39209  
**WATER WELL DRILLERS LOG**

**CODED**

**WASHINGTON**  
~~CI-2784~~ **Q104**

7/3 1985      LAYNE-CENTRAL CO.      WASHINGTON  
 date well completed      firm name      county well located

LANDOWNER:	description of formations encountered	from	to
WILLETT PLANTATION			
HOLLANDALE, MS	coarse sand	50	60
(mailing address)	coarse sand/gravel	60	120
<b>WELL LOCATION:</b>			
sec. <u>19</u> T <u>15</u> N R. <u>5</u> <del>E</del> W			
<u>5</u> miles <u>SE</u> of <u>Hollandale</u> (distance) (direction) (nearest town)			
<b>WELL PURPOSE:</b> <u>irrigation</u> (home, irrigation, municipal, industrial)			
<b>WELL COMPLETION DATA:</b>			
(1) diameter (inches) <u>32"</u>			
(2) total depth (feet) <u>120'</u>			
(3) static water level (feet) <u>19'</u> below above top of ground.			
(4) casing <u>steel</u> <u>70'</u> (material) (depth)			
<u>16"</u> (size) if telescope see back.			
(5) screen <u>50'</u> <u>70'</u> (length) (depth to top)			
<u>16"</u> <u>st. steel</u> (size) (material)			
(6) pump <u>60</u> <u>3000</u> (HP) (yield gpm)			
elec. (type power)			
(7) electric log <u>no</u> (yes or no)			
<u>st. plate</u> (organization running log)			
(8) how well bottom plugged _____			

**CODED**


**RECEIVED**  
 JUL 8 - 1985

Department of Natural Resources  
 Bureau of Land & Water Resources

DRILLERS REMARKS: \_\_\_\_\_

If well telescopes please sketch and show depths.

GROUND LEVEL

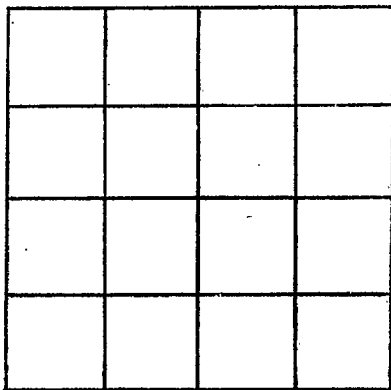

SECTION \_\_\_\_\_

Please indicate well location X.

ADDITIONAL INFORMATION

If more than one screen, show locations of each on sketch.