

MISSISSIPPI DEPARTMENT OF NATURAL RESOURCES

Bureau of Land and Water Resources

Southport Mall

P.O. Box 10631

Jackson, Mississippi 39209

WATER WELL DRILLERS LOG

CODED

WASHINGTON  
Q105  
3-18-85

March 18 1985 date well completed Lamp welly pump Washington firm name county well located

LANDOWNER: Ronald Duest

description of formations encountered

from

to

clay

0

25

Fine sand

25

52

Coarse sand & gravel

52

100

Delta City, ms.  
(mailing address)

WELL LOCATION:

sec. 19 T. 15 N. R. 5 E.  
5 miles N.W. of Murphy  
(distance) (direction) (nearest town)

CODED

WELL PURPOSE:


(home, irrigation, municipal, industrial)

WELL COMPLETION DATA:

- (1) diameter (inches) 8"
- (2) total depth (feet) 100'
- (3) static water level (feet) 22' below top of ground.
- (4) casing PVC, 60'  
(material) (depth)  
(size) If telescope see back.
- (5) screen 40', 60'  
(length) (depth to top)  
8", PVC  
(size) (material)
- (6) pump 20 1,000  
(HP) (yield gpm)  
E  
(type power)
- (7) electric log NO  
(yes or no)

(organization running log)

(8) how well bottom plugged PVC CAP

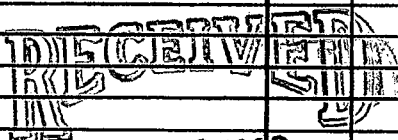


JUN 12 1985

Department of Natural Resources  
Bureau of Land & Water Resources

DRILLERS REMARKS:

If well telescopes please sketch and show depths.

GROUND LEVEL

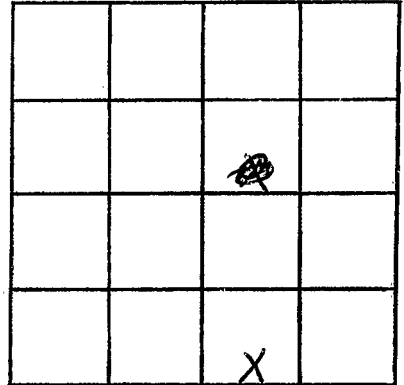

SECTION 19

Please indicate well location X.

ADDITIONAL INFORMATION

Lined area for additional information.

If more than one screen, show locations of each on sketch.