

MISSISSIPPI DEPARTMENT OF NATURAL RESOURCES

Bureau of Land and Water Resources

Southport Mall

P.O. Box 10631

Jackson, Mississippi 39209

WATER WELL DRILLERS LOG

CODED

WASHINGTON
 C2106
 3-18-85

Mon. 18 19 85 Lamps Well & Pump Washington
 date well completed firm name county well located

LANDOWNER: Donnell Must

description of formations encountered

from

to

clay	0	26
fine sand	26	31
coarse sand	31	100

Delta City, Mo.
 (mailing address)

WELL LOCATION:

sec. 15 T. 15 N. R. 5 W.
 5 miles N.W. of Murphree
 (distance) (direction) (nearest town)

CODED

WELL PURPOSE:


(home, irrigation, municipal, industrial)

WELL COMPLETION DATA:

- (1) diameter (inches) 8"
- (2) total depth (feet) 100'
- (3) static water level (feet) 22' below top of ground.
- (4) casing PVC, 100' (material) (depth)
- (size) If telescope see back.
- (5) screen 40' 60' (length) (depth to top)
- 8" PVC (size) (material)
- (6) pump 20 1000 (HP) (yield gpm)
- E (type power)
- (7) electric log No (yes or no)

(organization running log)

(8) how well bottom plugged PVC cap

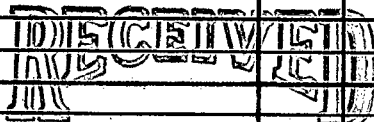


JUN 12 1986

Department of Natural Resources
 Bureau of Land & Water

DRILLERS REMARKS:

If well telescopes please sketch and show depths.

GROUND LEVEL

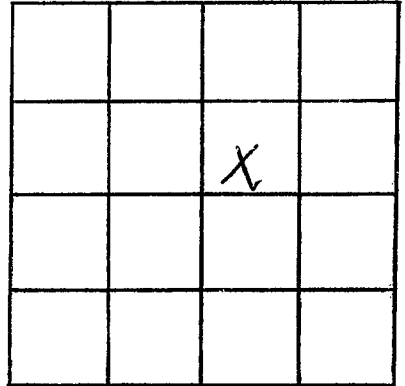

SECTION 19

Please indicate well location X.

ADDITIONAL INFORMATION

If more than one screen,
show locations of each on sketch.