

MISSISSIPPI DEPARTMENT OF NATURAL RESOURCES

Bureau of Land and Water Resources

Southport Mall

P.O. Box 10631

Jackson, Mississippi 39209

WATER WELL DRILLERS LOG

CODED

WASHINGTON
 Q 107
 3-19-85

March 19 1985 Larry's well & pump Washington
 date well completed firm name county well located

LANDOWNER: Craig Boykin

description of formations encountered

from to

Delta City, MS
 (mailing address)

clay	0	35
Fine sand	35	72
coarse sand & gravel	72	120

WELL LOCATION:

sec. 30 T. 15 N. R. 8 E. S. 5
 5 miles S of Murphy
 (distance) (direction) (nearest town)

CODED

WELL PURPOSE:

(home, irrigation, municipal, industrial)

WELL COMPLETION DATA:

- (1) diameter (inches) 8"
- (2) total depth (feet) 120'
- (3) static water level (feet) 23' below top of ground.
- (4) casing PVC, 80' (material) (depth)
 (size) if telescope see back.
- (5) screen 40' 80' (length) (depth to top)
 8" PVC (size) (material)
- (6) pump 20 1000 (HP) (yield gpm)
 E (type power)
- (7) electric log NO (yes or no)
 (organization running log)
- (8) how well bottom plugged PVC cap


RECEIVED
 JUN 12 1986

Department of Natural Resources
 Bureau of Land & Water Resources

DRILLERS REMARKS:

If well telescopes please sketch and show depths.

GROUND LEVEL

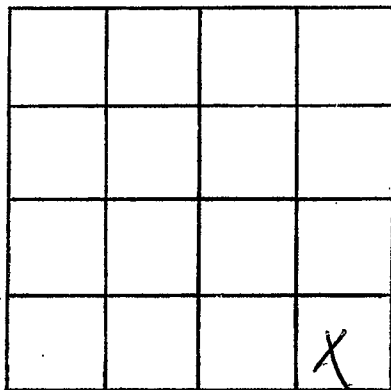

SECTION 30

Please indicate well location X.

ADDITIONAL INFORMATION

If more than one screen,
show locations of each on sketch.