

MISSISSIPPI DEPARTMENT OF NATURAL RESOURCES

Bureau of Land and Water Resources

Southport Mall

P.O. Box 10631

Jackson, Mississippi 39209

WATER WELL DRILLERS LOG

CODED

WASHINGTON  
Q 109

3-26-1986 date well completed  
Lump Well - pump firm name  
Washington county well located

LANDOWNER: Torrey Woods  
Hollandale, MS  
(mailing address)

description of formations encountered	from	to
slay	0	30
fine sand	30	50
course sand/gavel	50	100

WELL LOCATION:  
sec. 27 T 15 N R 5 E  
S S W  
1/4 mile E of Murphy  
(distance) (direction) (nearest town)

CODED

WELL PURPOSE:  
(home, irrigation, municipal, industrial)

WELL COMPLETION DATA:

(1) diameter (inches) 10"

(2) total depth (feet) 100'

(3) static water level (feet) 22 (below/above top of ground)


(4) casing plastic, 60' (material) (depth)  
(size) If telescope see back.

(5) screen 40' length, 100' depth to top  
10" size, plastic material

(6) pump 15 HP, 900 (yield gpm)  
E (type power)

(7) electric log NO (yes or no)  
(organization running log)

(8) how well bottom plugged PVC cap

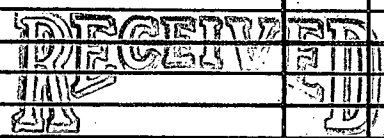


SEP 25 1986

Department of Natural Resources  
Bureau of Land and Water Resources

DRILLERS REMARKS:

If well telescopes please sketch and show depths.

GROUND LEVEL

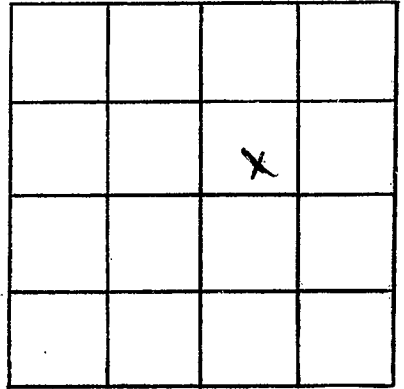

SECTION 27

Please indicate well location X.

ADDITIONAL INFORMATION

If more than one screen,  
show locations of each on sketch.