

22-3973

MISSISSIPPI DEPARTMENT OF NATURAL RESOURCES

Bureau of Land and Water Resources

COUNTY WELL LOCATED
WASHINGTON

WELL NUMBER **Φ 113** CODED

DATE WELL COMPLETED
6-23-88

PERMIT NUMBER

NAME OF DRILLING FIRM
LAYNE-CENTRAL CO.

Cleveland, Ms

P.O. Box 10631
 Jackson, Mississippi 39209
WATER WELL DRILLERS LOG

NAME & MAILING ADDRESS OF LANDOWNER
FONTENOT & FONTENOT RICE FARMS

RT. 1, BOX 75

HOLLANDALE, MS 38748

WELL LOCATION: SEC TOWNSHIP RANGE
 _____ 29 15 N 5 W

DISTANCE DIRECTION NEAREST TOWN
15 Miles SE of **HOLLANDALE**

OTHER LANDMARK

WELL PURPOSE: Home, Irrigation, Municipal, Industrial, Fish Pond, etc.
IRRIGATION

PUMP DATA

PUMP TYPE (Circle One):
 Submersible, Turbine, Jet Flowing Well,
 Other (Describe) _____

POWER TYPE (Circle One):
 Electric, Tractor, Diesel, Gasoline, Butane,
 Other (Describe) _____ H/P 60

Pump Capacity (GPM) No. of Stages Setting Depth
2400 1 85 FT.

PUMP TEST
 Well yielded NOT TESTED GPM with
 a drawdown of _____ ft.
 after _____ hours of pumping

WELL DATA

Well Depth 124'	Casing Diameter (In.) 16"	Casing Length (Ft.) 74'
Type of Casing ST. ST.	Hole Depth 124'	Depth to Static Water Level 33'

TYPE OF COMPLETION: (Circle One or More):
 Gravel Packed, Underreamed, Telescoped,
 Natural Development, Open Hole, Other
 (Describe) _____

Top of Lap Pipe or Reduction in Casing
N/A FEET IF TELESCOPED OR MORE THAN ONE SCREEN: USE BACK PAGE

LOG DATA

TYPE OF LOG RUN (Circle One): No Log Run
 Electric, Gamma Ray, Density, Sonic, Neutron,
 Other (Describe) _____

Name of Organization Running Log

SCREEN DATA

Diameter - Inches 16"	Length - Feet 50'	Slot Size - Inches .055
Screen Type ST. ST.	Depth to Bottom - Feet _____	

GEOLOGIC DATA (Office Use Only)

Surface Elev.	Geologic Unit	Unit Thickness	Depth to Top
Subs. SWL	Date	Analysis	Aquifer Test


Driller's Remarks

DESCRIPTION OF FORMATIONS ENCOUNTERED	FROM	TO	FORMATIONS (Continued)	FROM	TO
CLAY	0	18			
FIND SAND	18	48			
CLAY	48	60			
COARSE SAND	60	90			
COARSE SAND & PEA GR.	90	124			

IF MORE SPACE IS NEEDED, USE BACK

If well telescopes please
sketch and show depths:

GROUND LEVEL

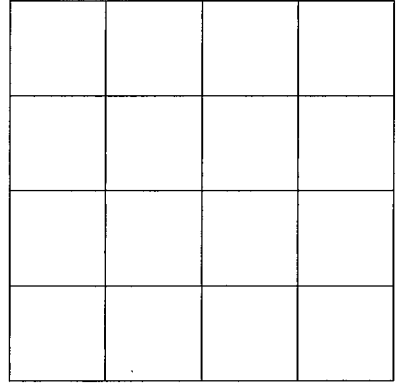

SECTION _____

Please indicate well location X.

ADDITIONAL INFORMATION

If more than one screen,
show location of each on sketch.