




If well telescopes please  
sketch and show depths.

IRRIGATION EQUIPMENT.  
601/887-2555  
INDIANOLA, MS

GROUND LEVEL

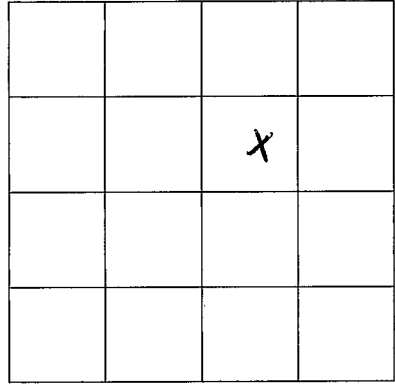

SECTION 4

Please indicate well location X.

ADDITIONAL INFORMATION

If more than one screen,  
show location of each on sketch.