County:	Washin	gton
Permit#:	6W40 jation	0688 Equipment
Driller:	ng completed:	11-11-05

## State Well Report

Part 1

Mississippi Department of Environmental Quality
Office of Land and Water Resources
P.O. Box 10631
Jackson, MS 39289-0631
(601)961-5210
(601)354-6938 (fax)

For Office Use Only:				
Aquifer: _				
Well #: _	Q-134			
L. S. Eleva	1			
E-log #: _				

State Law requires that this report be prepared by the driller in detail and filed with the Department within 30 days of completion of drilling of the well.


30 days of completion of drilling of the well.				
Well Owner Information	Well Location			
Owner Name Greer & Greer Farms	Latitude: 33, 09,50N, Longitude: 90,43,47W,			
Mailing Address: Box 637	Method of Lat/Long (circle one): Conventional Survey,			
	USGS quad, Hand-held GPS, Survey-grade GPS			
	SE 1/4 SE 1/4 Sec 8 Twn 15N Rng 5W			
Hollandale, MS 38748	Twin Ring			
City State Zip Code	Distance Direction Nearest Town			
Telephone No. ()	7 Miles East of Hollandale			
Well	Data			
Purpose of Well (circle one) Home Industrial Public Supply  Date well drilling started:  Date v	Urrigation Fish Culture Other: Replacement well drilling completed: 11-11-05			
If flowing, method of flow regulation: Valve Other (c	describe)			
Static Water Level: 32' feet above on below (circle one)				
Method of Measurement (circle one) steel tape electric tape	air line other:			
Hole depth: 116' Well depth: 116'	Well grouted to a depth offeet			
Type of grout (circle one): Cement Bentonite Mix				
Casing length: 76 feet Casing diameter: 16	inches Type of casing: PVC Sch. 40			
Screen length: 40 feet Screen diameter: 16	inches Type of screen: PVC Sch. 40			
Screen slot size:inches Setting depth: From _	77feet_to116feet			
Type of completion (circle all applicable): Gravel packed Under	rreamed Telescoped Open hole Natural Development			
Other (describe):				
Top of lap pipe or reduction in casing:feet. If to	elescoped or more than one screen, describe on back of page			
Logs run (circle all applicable): No log run Electric Gamma Ray	Density Sonic Neutron Other:			
Name of organization running log(s):				
I certify that the well was drilled, constructed, and completed in				
Department of Environmental Quality and/or the Mississippi De	partment of Health regulations and state laws.			
Irrigation Equipment Inc. Patrick M. Chism 0695	Patrick on Chin			
Print Name of Water Well Contractor and License No.	Signature of Water Well Contractor			

Q-

Ground Level

Description of Formations Encountered	From To_
Clay	0 21
Fine Sand	22 39
Fine Sand/gravel	40 68
Fine Sand/gravel Med. Sand/gravel	69116
·	
	_
	-

If more than one screen, show location of each on sketch

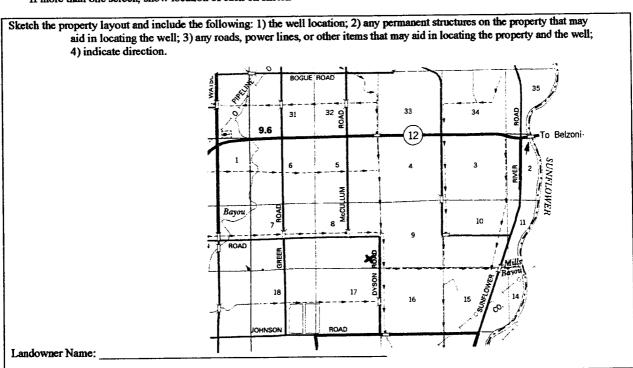

Signature of Water Well Contractor

## STATE WELL REPORT

## Part 2

County: Washington **Pump Installer's Completion Report** Mississippi Department of Environmental Quality
Office of Land and Water Resources P.O. Box 10631 Jackson, MS 39289-0631

For Office Use Only:		
Aquifer:		
Well #:	Q-134	
Elevation	:	

Date completed:	11-23-05		1961-5210 54-6938 (fax)	Elevation:		
This report s		he pump installer in deta	il and filed with the ]	Department within 30	days of the	
Well Owner Information		Well Location				
Owner Name:	Owner Name: Greer & Greer Farms		Latitude: Longitude:			
Mailing Address: Box 637		Method of Lat/Long (circle one): Conventional Survey,				
			USGS qu	ıad, Hand-held GPS,	Survey-grade GPS	
_	Hollandale	MS 38748	SE 4SE 4	Sec_8_Twn_1	5N <sub>Rng</sub> 5W	
	City State	Zip Code		irection Nearest		
Геlephone No. (_	)		7 Miles Ea	st of Holla	andale	
Pump Type			Power Type			
N:- T 10-	Circle one			Circle one		
Air Lift	Jet	Submersible	Diesel Engine	Gasoline Engine	Natural Gas	
Bucket	Piston	Turbing	Electric Motor	Hand	Tractor PTO	
Centrifugal	Rotary	Flowing Well	Windmill	Other (specify):		
			Horse Power Rating	of Motor: 60		
Date Pump Installed: 11-23-05		Setting Depth:	70	feet		
Rated Pump Capac	ity: 2500-3000	Gallons Per Minute	i	1		
Pump Test Data		Method of Measuring Water Level Circle one				
Date Well Tested:			Air Line Ele	ectric Measuring Line	Steel Tape	
	(A):Feet				-	
	(A)]:Feet		For flowing well, me	easured shut in head: _	feet	
Test Pumping Rate:Gallons Per Minute		Well yielded	GPM with	a drawdown of		
Ouration of Pump	Test (minimum 4 hours):	hours	fe	et after	_hours of pumping	
Patric		neats are true to the best of	Patrick 1	M Chung f Pump Installer		

RECEIVED

DEC 0 5 2005

BY: OLWR