County:	Washington	
'-	gation	44619 Equipment
Date dril	lling completed:	3-13-07

State Well Report

Part 1

Mississippi Department of Environmental Quality Office of Land and Water Resources P.O. Box 10631 Jackson, MS 39289-0631 (601)961-5210 (601)354-6938 (fax)

For Office Use Only:	
Aquifer:	
Well #: <u>Q - 141</u>	_
L. S. Elevation:	_
E-log #:	


State Law requires that this report be prepared by the driller in detail and filed with the Department within

30 days of completion of drilling of the well.	armer m down and more and more armer and more armer and more armer			
Well Owner Information	Well Location			
Owner Name Greer & Greer	33 09 38.5 90 44 5,9.6 Latitude: Sq. Longitude: 59			
Mailing Address: Box 637	Method of Lat/Long (circle one): Conventional Survey,			
	USGS quad, Hand-held GPS, Survey-grade GPS			
	ME ₁ SE 1 Sec 7 Twn 15N Rng 5W			
Hollandale MS 38748	 / * * * * 			
City State Zip Code	Distance Direction Nearest Town 6 Miles East of Murphy			
Telephone No. ()				
Well 1	Data			
The state of the s	THOM: OH			
Purpose of Well (circle one) Home Industrial Public Supply	(Irrigation Fish Culture Other:			
Date well drilling started: 3-13-07 Date w	well drilling completed: 3-13-07			
If flowing, method of flow regulation: Valve Other (d	escribe)			
Static Water Level: 29' feet above of below (circle one) l	and surface Date measured: 3-14-07			
Method of Measurement (circle one) steel take electric tape	air line other:			
Hole depth: 116 Well depth: 116 Well grouted to a depth of 10 feet				
Type of grout (circle one): Cement Bentonre Mix				
Casing length: 76 feet Casing diameter. 16	inches Type of casing: PVC Sch. 40			
Screen length: 40 feet Screen diameter: 16	inches Type of screen: <u>PVC Sch. 40</u>			
Screen slot size: inches Setting depth: From	See Back feet to feet			
Type of completion (circle all applicable): Gravel packed Under	теаmed Telescoped Open hole Natural Development			
Other (describe):	į.			
Top of lap pipe or reduction in casing: feet. If te	lescoped or more than one screen, describe on back of page			
Logs run (circle all applicable): No log run Electric Gamma Ray	Density Sonic Neutron Other:			
Name of organization running log(s):				
I certify that the well was drilled, constructed, and completed in accordance with all applicable requirements of the Mississippi				
Department of Environmental Quality and/or the Mississippi De	partment of Flealth regulations and state laws.			
Irrigation Equipment Inc.	() / .			
Patrick M. Chism 0695	- tatul in c			
Print Name of Water Well Contractor and License No.	Signature of Water Well Contractor			

Ground Level

Description of Formations Encountered	From	То
Clay	_0	18
Fine Sand	19	35
Fine Sand/gravel	36	49
Med. Sand/gravel	50	85
Fine Sand	86	91
Med. Sand/gravel	92	116
Tica: Bund/graver		
	1	
Screen 20' 66 85		
Screen 20' 66-85 Screen 20' 97-116		1
Screen 20 9/-116	 	
		
	 	\vdash
	+	+1
	+	-
		-
		1
		ļ
		<u> </u>
		1

If more than one screen, show location of each on sketch

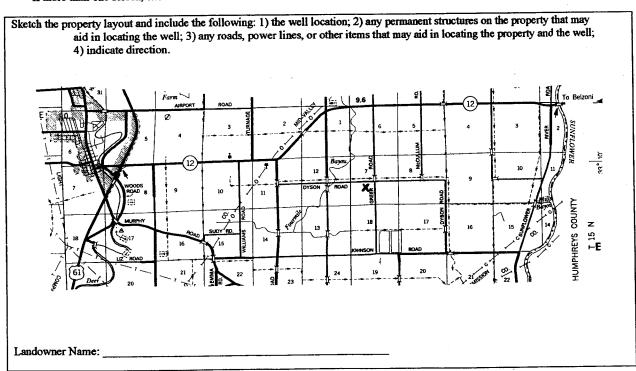

Signature of Water Well Contractor

STATE WELL REPORT

Washington County:__ Pennit#: 6w 4/6/9 Irrigation Equipment 3-13-07

Part 2 Primp Installer's Completion Report
Mississippi Department of Environmental Quality
Office of Land and Water Resources
P.O. Box 10631
Jackson, MS 39289-0631
(601)961-5210

For Office Use Only:	
Aquifer:	
Well#: Q ~ 14//	
Elevation:	

Dae complete: 3-13-0/	(601)354-0	-6938 (fax) Elevation:
This report should be prepared by the pump inst installation of pump.	aller in detail :	and filed with the Department within 30 days of the
Well Owner Information		Well Location
OwnerName: Greer & Greer	!:	Latitude: Longitude:
Mailing Address: Box 637	P	Method of Lat/Long (circle one): Conventional Survey,
		USGS quad, Hand-held GPS, Survey-grade GPS
	88748	NE 14 SE 14 Sec 7 Twn 5N Rng 5W
City State Zip C		Distance Direction Nearest Town
Telephone No. ()		6 Miles East of Murphy
Pump Type Circle one		Power Type Circle one
Air Lift Jet Submersible	. г	Diesel Engine Gasoline Engine Natural Gas
Bucket Piston Turbine	(Electric Motor Hand Tractor PTO
Centrifugal Rotary Flowing We	ell v	Windmill Other (specify):
Other (specify):	_ E	Horse Power Rating of Motor: 60
Date Pump Installed: 3-14-07		Setting Depth: 70 feet
Rated Pump Capacity: 2800 ± Gallons Per I	Minute N	Number of Stages: 1
Pump Test Data		Method of Measuring Water Level
Date Well Tested:		Circle one
Static Water Level (A): Feet Below Land Surface		Air Line Electric Measuring Line Steel Tape
Pumping Water Level (B):Feet Below Land Surface		Other (specify):
Drawdown [(B)-(A)]: Feet Below Land Surface		For flowing well, measured shut in head:feet
Test Pumping Rate:Gallons Per Minute		Well yieldedGPM with a drawdown of
Duration of Pump Test (minimum 4 hours):hours		feet after hours of pumping
	······································	<u> </u>

I HEREBY CERTIFY that the above statements are true to the bes	st of my knowledge.
Patrick M. Chism 0695	Patty me
Print Name of Pump Installer and License No. (if applicable)	Signature of Pump Installer