

State Well Report

Part 1 - Driller's Log

Mississippi Department of Environmental Quality
Office of Land and Water Resources
P.O. Box 10631
Jackson, MS 39289-0631
(601)961-5210
(601)354-6938 (fax)

For Office Use Only:

Aquifer: _____
Well #: Q-142
L. S. Elevation: _____
E-log #: _____

County: Washington
Permit #: QW 41930
Driller: Charles M. Nichols
Date drilling completed: 4-5-07

State Law requires that this report be prepared by the license holder responsible for the work and filed with the Department at the above address within 30 days of completion of drilling of the well or borehole.

Information on Well Owner (Landowner if borehole is not for a water well)	Well or Borehole Location
Owner Name: <u>Jason Smith</u>	Latitude: <u>33° 09' 36N</u> Longitude: <u>090° 42' 21W</u>
Mailing Address: <u>141 Roth Rd.</u>	Method of Lat/Long (circle one): Conventional Survey, _____
<u>Leland MS 38756</u>	USGS quad: <u>Hand-held GPS</u> , Survey-grade GPS
City State Zip Code	<u>NW 1/4 NW 1/4 Sec 10 Twn 15N Rng 5W</u>
Telephone No. () _____	Distance Direction Nearest Town <u>9</u> Miles <u>East</u> of <u>Hollandale</u>

Well / Borehole Data

Date drilling started: 4-5-07 Date drilling completed: 4-5-07 Hole depth: 110 Hole diameter: 28

Location of the source of any surface water used for drilling: Bayou

Method of dosing and volume of Chlorine used in drilling and development: HTH

Logs run (circle all applicable): No log run Electric Gamma Ray Density Sonic Neutron Other: _____

Name of organization running log(s): _____

Purpose of borehole (check one): Water Well Geotechnical/Geological Investigation _____ Ground Source Heat Pump _____

Seismic Survey _____ Other (describe) _____

If drilling is not related to water well construction, skip the remainder of this block

Purpose of Well (check one): Home _____ Industrial _____ Public Supply _____ Irrigation Fish Culture _____ Other: Replaced

If a flowing well, method of flow regulation: Valve _____ Other (describe) GW 39962

Static Water Level: 26 feet above or below (circle one) land surface Date measured: 4-5-07

Method of Measurement (circle one) steel tape electric tape air line other: _____

Well depth: 110 Well grouted to a depth of 10 feet Type of grout (circle one): Near Cement Bentonite Mix

Casing length: 70 feet Casing diameter: 16 inches Type of casing: pvc

Screen length: 40 feet Screen diameter: 16 inches Type of screen: pvc

Screen slot size: .035 inches Setting depth: From 70 feet to 110 feet

Type of completion (circle all applicable): Gravel packed Underreamed Telescoped Open hole Natural Development

Other (describe): _____

Top of lap pipe or reduction in casing: _____ feet. *If telescoped or more than one screen, describe on next page*

Form: OLWR-SWR-1A

RECEIVED
JUN 27 2007
BY: OLWR


6W41930

Q-142

The sketch below only required for water wells


Description of formations encountered must be provided for all wells and boreholes, unless specifically exempted by regulations

If well telescopes, show depths on sketch

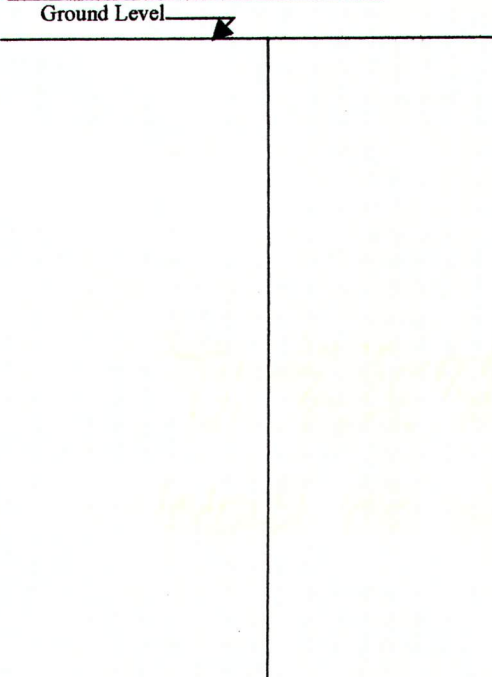

Description of Formations Encountered	From (depth)	To (depth)
clay	Ground Level	15
mod sand	15	30
course sand	30	70
course sand + p-gravel	70	100
course sand	100	110
cemented gravel	110	

If more than one screen, show location of each on sketch

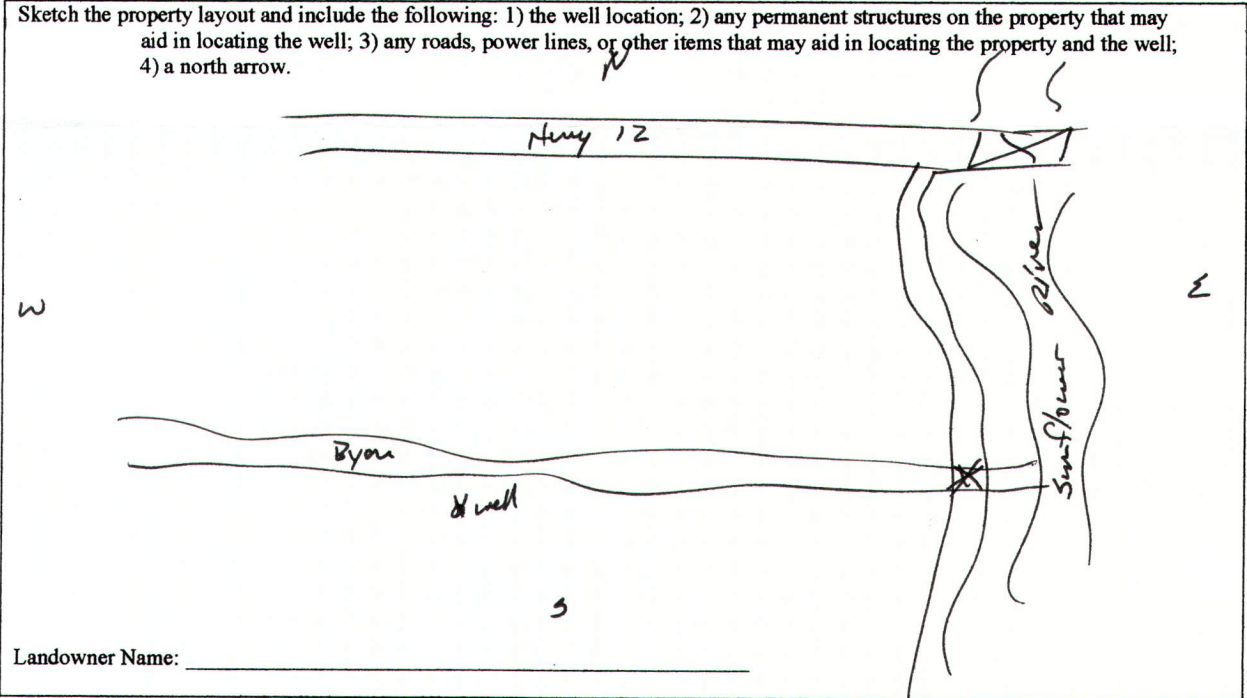

Form: OLWR-SWR-1A

I certify that the well/borehole was drilled, constructed, and completed in accordance with all applicable requirements of the Mississippi Department of Environmental Quality and the Mississippi Department of Health regulations, if applicable, and state laws.

Charles M. Nichols 00667 4-16-07

Print Name of Responsible Licensee and License No.

Date

Signature of Licensee

RECEIVED
JUN 27 2007
BY: OLWR

STATE WELL REPORT

Part 2

Pump Installer's Completion Report
 Mississippi Department of Environmental Quality
 Office of Land and Water Resources
 P.O. Box 10631
 Jackson, MS 39289-0631
 (601)961-5210
 (601)354-6938 (fax)

County: Washington
 Permit #: 6W41930
 Driller: Charles M. Nichols
 Date completed: 4-7-07
Copy information from block on Part 1

For Office Use Only:

Aquifer: _____
 Well #: Q-142
 Elevation: _____

This part of the report must be completed by a licensed water well contractor or a licensed pump installer. A copy of Part 1 of the report must be attached and both parts filed with the Department at the above address within 30 days of well completion.

Well Owner Information	Well Location
Owner Name: <u>JASON SMITH</u>	Latitude: <u>33° 09' 36N</u> Longitude: <u>090° 42' 21W</u>
Mailing Address: <u>141 Roth Rd.</u>	Method of Lat/Long (check one): Conventional Survey _____
<u>Leland MS 38756</u>	USGS quad <u>Hand-held GPS</u> , Survey-grade GPS _____
City State Zip Code	_____ ¼ _____ ¼ Sec _____ T _____ R _____
Telephone No. () _____	Distance Direction Nearest Town
	<u>9</u> Miles <u>East</u> of <u>Hollandale</u>

Pump Type Circle one	Power Type Circle one
Air Lift Jet Submersible	Diesel Engine Gasoline Engine Natural Gas
Bucket Piston <u>Turbine</u>	<u>Electric Motor</u> Hand Tractor PTO
Centrifugal Rotary Flowing Well	Windmill Other (specify): _____
Other (specify): _____	Horse Power Rating of Motor: <u>40</u>
Date Pump Installed: <u>4-7-07</u>	Setting Depth: <u>60</u> feet
Rated Pump Capacity: <u>200</u> Gallons Per Minute	Number of Stages: <u>1</u>

Pump Test Data	Method of Measuring Water Level Circle one
Date Well Tested: _____	Air Line Electric Measuring Line Steel Tape
Static Water Level (A): <u>26</u> Feet Below Land Surface	Other (specify): _____
Pumping Water Level (B): _____ Feet Below Land Surface	For flowing well, measured shut in head: _____ feet
Drawdown [(B) - (A)]: _____ Feet Below Land Surface	Well yielded _____ GPM with a drawdown of
Test Pumping Rate: _____ Gallons Per Minute	_____ feet after _____ hours of pumping
Duration of Pump Test (minimum 4 hours): _____ hours	

I HEREBY CERTIFY that the above statements are true to the best of my knowledge.

Charles M. Nichols 0-0667 Charles M. Nichols
 Print Name of Pump Installer and License No. (if applicable) Signature of Pump Installer

Form: OLWR-SWR-1B
RECEIVED
JUN 27 2007
BY: OLWR