

WASH.

MISSISSIPPI BOARD OF WATER COMMISSIONERS

~~P-50~~ Q1001

6-11-57

WATER WELL DRILLERS LOG

CODED

10/15/65
443

Date: June 11, 1957, Driller: Layne-Central Company County Washington

(Name)

(1) Owner of Land: Greer Brothers

(Name)

Hollandale, Mississippi

(Address)

(2) Location: 1/4, 1/4, Sec. 18, T. 5N, R. 15W

8 miles southeast of Hollandale
(distance) (direction) (Nearest Town)

(3) Topography: flat

(Hilly) (Flat) (Level)

(4) Purpose of Well: irrigation

(Domestic Irrigation
Municipal, Industrial, Other)

Description & Color of Materials Sand, Clay, Red Clay, Shell, etc.	Thick- ness Feet	Depth Feet
Clay	39	39
Coarse sand & clay balls	5	44
Coarse sand	13	57
Fine blue sand & clay balls	7	64
Coarse sand & pea rock	8	82
Sand & gravel	10	92
Sand & gravel	20	112
Coarse sand & gravel	10	122

Information upon completion of well:

(1) Diameter 18x16 inches.

(2) Total Depth 122 feet.

(3) Water Level 16'7" feet below top of ground.

(4) Cased to 70', Size 18" 2' of 18" x 16" swage

(5) Screen: Size 16", Length 50'

(6) Were any formations sealed against pollution?

yes, no no.

If YES depth of formation

Why


Drillers Remarks:

2800 GPM.

Electric power.

CODED

Ineff. info.
to locate

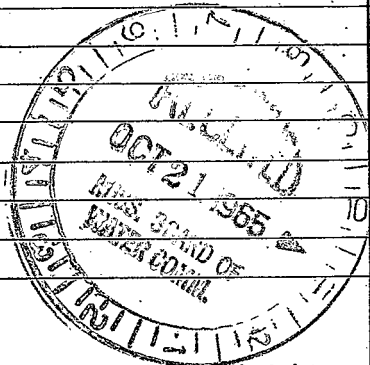

(Use Back Side)

Well No.

