

MISSISSIPPI DEPARTMENT OF NATURAL RESOURCES

Bureau of Land and Water Resources

Southport Mall

P.O. Box 10631

Jackson, Mississippi 39209

WATER WELL DRILLERS LOG

Washington  
Q 2001

8-13-82 1982  
date well completed

Larry's Well & Pump  
firm name

Washington  
county well located

LANDOWNER: Tony Wood

description of formations encountered

from

to

Hollandale, ms  
(mailing address)

<u>clay</u>	<u>0</u>	<u>20</u>
<u>med. sand</u>	<u>20</u>	<u>30</u>
<u>coarse sand</u>	<u>30</u>	<u>80</u>
<u>coarse sand/good</u>	<u>80</u>	<u>140</u>
<u>clay</u>	<u>140</u>	<u>230</u>
<u>clay &amp; sand</u>	<u>220</u>	<u>385</u>
<u>sand</u>	<u>385</u>	<u>425</u>
<u>clay</u>	<u>425</u>	<u>570</u>
<u>fine sand</u>	<u>570</u>	<u>630</u>
<u>med. sand</u>	<u>630</u>	<u>670</u>

WELL LOCATION:

sec. 34 T 15 N R — E  
S 5 W  
1 miles South of Murphy  
(distance) (direction) (nearest town)

WELL PURPOSE: Home  
(home, irrigation, municipal, industrial)

WELL COMPLETION DATA: 135=4"

- (1) diameter (inches) 4" x 2"
- (2) total depth (feet) 670
- (3) static water level (feet) 22 below above top of ground.
- (4) casing plastic, 640'  
(material) (depth)  
(size) If telescope see back.
- (5) screen 30", 640'  
(length) (depth to top)  
2", plastic  
(size) (material)
- (6) pump 2 40  
(HP) (yield gpm)  
Electric  
(type power)
- (7) electric log NO  
(yes or no)

DEPT. OF NATURAL RESOURCES  
BUREAU OF LAND & WATER RESOURCES

DEC - 3 1982

RECEIVED


(organization running log)

(8) how well bottom plugged

DRILLERS REMARKS:

If well telescopes please sketch and show depths.

GROUND LEVEL

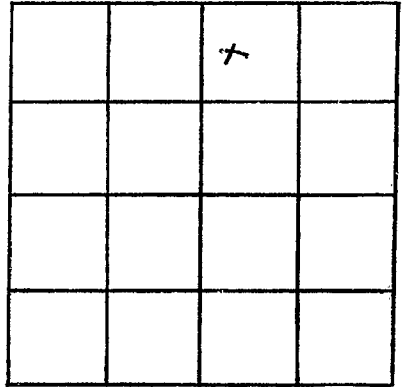

SECTION 34

Please indicate well location X.

ADDITIONAL INFORMATION

If more than one screen,  
show locations of each on sketch.