

MISSISSIPPI DEPARTMENT OF NATURAL RESOURCES

Bureau of Land and Water Resources

Southport Mall

P.O. Box 10631

Jackson, Mississippi 39209

WATER WELL DRILLERS LOG

Washington  
Q 2003

Feb 14 1985 Larry's Well & Pump

Washington

LANDOWNER: Cecil Nightingale

description of formations encountered

from to

Leland, ms.

(mailing address)

|               |     |     |
|---------------|-----|-----|
| Top           | 0   | 15  |
| Gravel & Sand | 15  | 145 |
| Clay          | 145 | 260 |
| Sand          | 260 | 390 |
| Clay          | 390 | 450 |
| Sand          | 450 | 525 |

WELL LOCATION:

sec. 19 T. 15 N. R. 5 E  
S 13 miles E of Hattala  
(distance) (direction) (nearest town)

WELL PURPOSE:

(home, irrigation, municipal, industrial)

WELL COMPLETION DATA:

- (1) diameter (inches) 4" x 2"
- (2) total depth (feet) 525
- (3) static water level (feet) 20' below top of ground.
- (4) casing PVC, 495' (material) (depth)  
4 1/2" (size) If telescope see back.
- (5) screen 30' PVC, 495 to 525' (length) (depth to top)  
2" (size) (material)
- (6) pump 1 HP, 15 (yield gpm)  
230 (type power)
- (7) electric log No (yes or no)

(organization running log)

(8) how well bottom plugged Shank

RECEIVED  
NOV 12 1986

Department of Natural Resources  
Bureau of Land & Water Resources

DRILLERS REMARKS:


If well telescopes please sketch and show depths.

GROUND LEVEL

120' 4" P.V.E.

405' 2" P.V.E.

30' 2" P.V.E. SCREEN

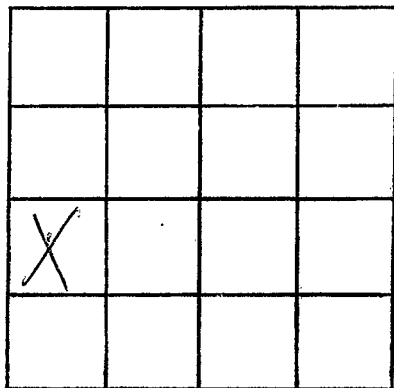

SECTION 10

Please indicate well location X.

ADDITIONAL INFORMATION

If more than one screen, show locations of each on sketch.