

WASHINGTON

COUNTY WELL LOCATOR

WELL NUMBER 2003 CODEDDATE WELL COMPLETED
7-17-90

MISSISSIPPI DEPARTMENT OF NATURAL RESOURCES

Bureau of Land and Water Resources

PERMIT NUMBER
MS-GW-08659NAME OF DRILLING FIRM
Dym Well

P.O. Box 10631

Jackson, Mississippi 39209

WATER WELL DRILLERS LOG

NAME & MAILING ADDRESS OF LANDOWNER

Harrel B. Potter501 Sunflower St.Belzoni, Ms. 39038WELL LOCATION: SEC 3 TOWNSHIP 15 RANGE 5
N S E W

DISTANCE _____ MILES _____ of _____

OTHER LANDMARK

WELL PURPOSE: Home, Irrigation, Municipal, Industrial, Fish Pond, etc.

PUMP DATA

PUMP TYPE (Circle One):
Submersible, Turbine, Jet, Flowing Well,
Other (Describe) _____POWER TYPE (Circle One):
Electric, Tractor, Diesel, Gasoline, Butane,
Other (Describe) _____ H/P _____Pump Capacity (GPM) 3000 No. of Stages 1 Setting Depth 60 FT.

PUMP TEST

Well yielded _____ GPM with
a drawdown of _____ ft.
after _____ hours of pumping

WELL DATA

Well Depth 117' Casing Diameter (In.) 16" Casing Length (Ft.) 77'Type of Casing steel Hole Depth _____ Depth to Static Water Level _____TYPE OF COMPLETION: (Circle One or More):
Gravel Packed, Underreamed, Telescoped,
Natural Development, Open Hole, Other
(Describe) _____

Top of Lap Pipe or Reduction in Casing

FEET IF TELESCOPED OR MORE THAN ONE SCREEN: USE BACK PAGE

SCREEN DATA

Diameter - Inches 16" Length - Feet 40' Slot Size - Inches .030Screen Type Wire Wrap Depth to Bottom - Feet _____

LOG DATA

TYPE OF LOG RUN (Circle One): No Log Run
Electric, Gamma Ray, Density, Sonic, Neutron,
Other (Describe) _____Name of Organization Running Log
None

GEOLOGIC DATA (Office Use Only)

Surface Elev.	Geologic Unit	Unit Thickness	Depth to Top
Subs. SWL	Date	Analysis	Aquifer Test

Driller's Remarks


RECEIVEDOCT 26 1990

DESCRIPTION OF FORMATIONS ENCOUNTERED	FROM	TO	FORMATIONS (Continued)	FROM	TO
<u>CLAY</u>	<u>0</u>	<u>18</u>	Department of Natural Resources Bureau of Land & Water Resources		
<u>Fine Sand</u>	<u>18</u>	<u>32</u>			
<u>Fine Sand + Gravel</u>	<u>32</u>	<u>52</u>			
<u>M Sand + Gravel</u>	<u>52</u>	<u>64</u>			
<u>Fine Sand + Gravel</u>	<u>64</u>	<u>89</u>			
<u>M Sand + Gravel</u>	<u>89</u>	<u>104</u>			
<u>Sand + Gravel</u>	<u>104</u>	<u>117</u>			

IF MORE SPACE IS NEEDED, USE BACK

If well telescopes please
sketch and show depths.

GROUND LEVEL

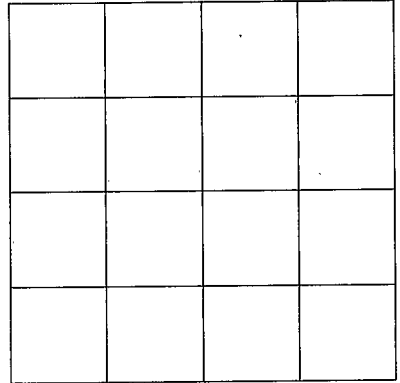

SECTION _____

Please indicate well location X.

ADDITIONAL INFORMATION

If more than one screen,
show location of each on sketch.