

R 27

WATER WELL DRILLERS LOG

7-66

Washington

Date: 7-6, 1966, Driller: Butam Gas Co. of Wood County Leffers
 (Name)

(1) Owner of Land: Howard New
 (Name)
Chatham, Miss.
 (Address)

(2) Location: SE 1/4, NW 1/4, Sec. 25 T4 R9 W
3 miles S of Chatham
 (distance) (direction) (Nearest Town)

(3) Topography: Flat
 (Hilly) (Flat) (Level)

(4) Purpose of Well: Irrigation
 (Domestic, Irrigation, Municipal, Industrial, Other)

Description & Color of Materials Sand, Clay, Red Clay, Shell, etc.	Thick- ness Feet	Depth Feet
Clay	13	13
Clay	10	23
Clay	10	33
Fine Sand	10	43
Fine Sand	10	53
Med. Sand	10	63
Coarse Sand	10	73
Coarse Sand - Gravel	10	83
Coarse Sand - Gravel	10	93
Coarse Sand - Gravel	10	103

Information upon completion of well:

(1) Diameter 16 inches.

(2) Total Depth 103 feet.

(3) Water Level 17 feet below top of ground.

(4) Cased to 63, Size 16


(5) Screen: Size 16, Length 40

(6) Were any formations sealed against pollution?
 _____ yes, X no.

If YES depth of formation _____

Why _____

Drillers Remarks: _____

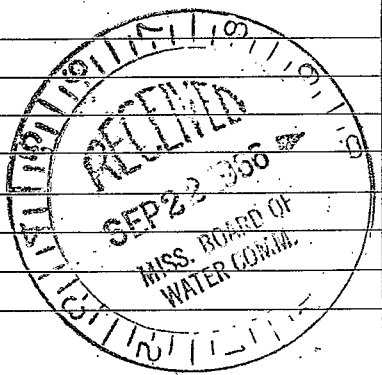

(Use Back Side)

Well No.

