

R 33
 WASHINGTON
 7-6-73

MISSISSIPPI
 BOARD OF WATER COMMISSIONERS
 416 North State Street
 Jackson, Mississippi 39201

COPIED
 C17

WATER WELL DRILLERS LOG


July 6, 19 73 Singer-Layne Central Div. Washington
 date well completed firm name county well located

LANDOWNER:	description of formations encountered	from	to
Cecil Wingfield	Sandy Clay	0	18
Glen Allan, Mississippi (mailing address)	Fine Sand	18	55
	Coarse Sand	55	60
WELL LOCATION: sec. 28 T 14 N 3 W R 9 E W miles of Glen Allan (distance) (direction) (nearest town)	Coarse Sand & Pea Gravel	60	98
	Coarse Sand & Gravel	98	104
	Coarse Sand & Big Gravel	104	109
WELL PURPOSE: Irrigation (home, irrigation, municipal, industrial)			
WELL COMPLETION DATA:			
(1) diameter (inches) 12"			
(2) total depth (feet) 109'			
(3) static water level (feet) 10' below top of ground.			
(4) casing Steel 69' (material), (depth)			
12" (size) if telescope see back.			
(5) screen 40' 109' (length), (depth to top)			
12" Armco Iron (size), (material)			
(6) pump 80 2000 (HP) (yield gpm)			
Engine (type power)			
(7) electric log No (yes or no)			
(organization running log)			
(8) how well bottom plugged Plate			
DRILLERS REMARKS:			

AUG 13 1973

If well telescopes please sketch and show depths.

GROUND LEVEL

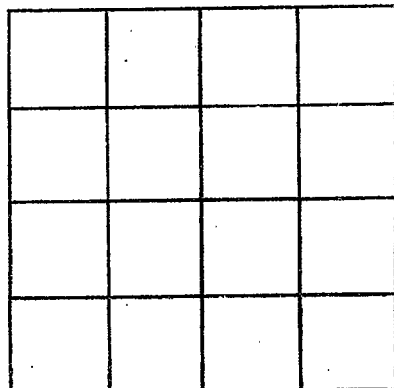

SECTION _____

Please indicate well location X.

ADDITIONAL INFORMATION

If more than one screen,
show locations of each on sketch.