

WASH.  
R 37  
2-21-74

MISSISSIPPI  
BOARD OF WATER COMMISSIONERS  
416 North State Street  
Jackson, Mississippi 39201

CODED

WATER WELL DRILLERS LOG

Feb 21, 1974 date well completed  
OWENS Plumbing firm name  
Wash county well located

LANDOWNER: W. T. TURCH BERRY

| description of formations encountered | from | to  |
|---------------------------------------|------|-----|
| top soil                              | 0    | 30  |
| clay                                  | 30   | 100 |
| sand & gravel                         | 100  | 200 |
| sand                                  | 200  | 312 |
| sand & shells                         | 312  | 484 |
| sand                                  | 484  | 662 |

Rolling Fork, Miss (mailing address)

WELL LOCATION:

sec 27 T 14 N R 9 E  
5 14 W of Gallen  
(distance) (direction) (nearest town)

WELL PURPOSE: Home  
(home, irrigation, municipal, industrial)

WELL COMPLETION DATA:

- (1) diameter (inches) 4" x 2"
- (2) total depth (feet) 662 Ft.
- (3) static water level (feet) 30' below top of ground
- (4) casing Galv. (material) 1032' (depth)
- (size)          if telescope see back.
- (5) screen 30' (length) 662' (depth to top)
- 2" (size) S. Steel (material)
- (6) pump 1 1/2 (HP) 50 (yield gpm)
- F.I.E.C. (type power)
- (7) electric log          (yes or no)
- (organization running log)
- (8) how well bottom plugged S.B.

CODED


MISSISSIPPI BOARD OF WATER COMMISSIONERS  
APR 5 1974

DRILLERS REMARKS:

OWENS

If well telescopes please sketch and show depths.

GROUND LEVEL

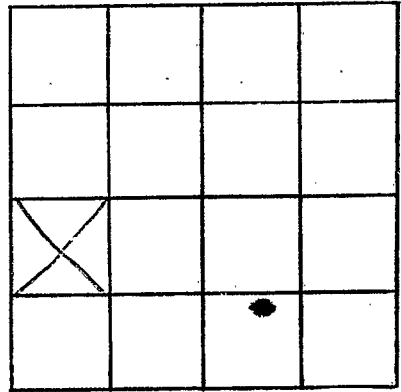

SECTION \_\_\_\_\_

Please indicate well location X.

ADDITIONAL INFORMATION

If more than one screen, show locations of each on sketch.