

RECEIVED

WASHINGTON
R 38
4-26-74

MISSISSIPPI
BOARD OF WATER COMMISSIONERS
416 North State Street
Jackson, Mississippi 39201

MAY 8 1974

CODED

AIR & WATER POLLUTION
CONTROL COMMISSION
STATE OF MISSISSIPPI

WATER WELL DRILLERS LOG

4-26
date well completed

1974 Owens plog.
firm name

Wash.
county well located

LANDOWNER: R.E. Fleming
Rt 273 E
Hollandale Miss.
(mailing address)

description of formations encountered	from	to
top soil	0	10
Clay	10	226
Sand	226	242
Sand & gravel	242	292
Sand & pebbles	292	302
Sand	302	402

WELL LOCATION:

sec. 24 T. 14 N. S. R. 8 W. W

(distance) miles (direction) of (nearest town)

WELL PURPOSE: Home
(home, irrigation, municipal, industrial)

WELL COMPLETION DATA:

- (1) diameter (inches) 4" x 2"
- (2) total depth (feet) 402 Ft.
- (3) static water level (feet) 13 below top of ground.
- (4) casing Steel 382' (material) (depth)
- (size) If telescope see back.
- (5) screen 20' 482' (length) (depth to top)
- 2" S.S. (size) (material)
- (6) pump 1 1/2 50 (HP) (yield gpm)
- Plec. (type power)
- (7) electric log NO (yes or no)

(organization running log)

(8) how well bottom plugged S.B.

DRILLERS REMARKS: Owens


CODED

MAY 8 1974

COLEMAN

If well telescopes please sketch and show depths.

GROUND LEVEL

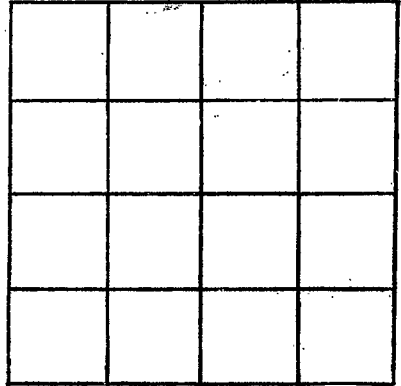

SECTION _____

Please indicate well location X.

ADDITIONAL INFORMATION

If more than one screen, show locations of each on sketch.