

WASH

R-39

3-18-80

MISSISSIPPI BOARD OF WATER COMMISSIONERS 416 North State Street Jackson, Mississippi 39201

CODED

WATER WELL DRILLERS LOG

3112

1980 COMMAGE Drilling Wash

date well completed

firm name

county well located

LANDOWNER: BERKELEY GIN

description of formations encountered

from

to

CLAY SAND 0 20 20 75

GRAVEL & SAND 75 105

MUD 105 480

ROCK 480 480

MUD 480 500

ROCK CODED 500 500

MUD 500 565

ROCK 565 565

MUD 565 680

SAND 680 740

MUD 740 770

ROCK 770 771

MUD 771 780

(mailing address)

WELL LOCATION:

sec 14 T 15 N R 9 E 3 miles S of Nathan (distance) (direction) (nearest town)

WELL PURPOSE: INDUSTRIAL (home, irrigation, municipal, industrial)

WELL COMPLETION DATA:

(1) diameter (inches) 4-2 1/2 - 2

(2) total depth (feet) 722

(3) static water level (feet) 36' below top of ground.

(4) casing 150-708 (material) 708 (depth)

4-2 1/2 - 2 If telescope see back. (size)

(5) screen 15 708 (length) (depth to top)

2" 10 dot STAINLESS STEEL (size) (material)

(6) pump 2 HP 35 (HP) (yield gpm)

Electric (type power)

(7) electric log No (yes or no)

(organization running log)

(8) how well bottom plugged BACK PRESSURE VALVE

DRILLERS REMARKS:


DEPT. OF NATURAL RESOURCES BUREAU OF LAND & WATER RESOURCES

MAR 24 1980

RECEIVED

If well telescopes please  
sketch and show depths.

GROUND LEVEL

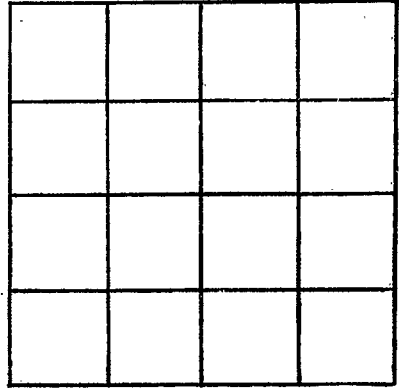

SECTION \_\_\_\_\_

Please indicate well location X.

ADDITIONAL INFORMATION

If more than one screen,  
show locations of each on sketch.