

Washington  
R 48  
5-12-81

MISSISSIPPI DEPARTMENT OF NATURAL RESOURCES  
Bureau of Land and Water Resources  
Southport Mall  
P.O. Box 10631  
Jackson, Mississippi 39209  
WATER WELL DRILLERS LOG

5-12-81 date well completed      Dyer firm name      Washington county well located

LANDOWNER:  
Robray Fisher  
Coker Allen, MS  
(mailing address)

WELL LOCATION:  
sec. 26 T 14 N R 9 E  
1 miles W of Chatham  
(distance) (direction) (nearest town)


WELL PURPOSE: Municipal  
(home, irrigation, municipal, industrial)

- WELL COMPLETION DATA:
- (1) diameter (inches) 16"
  - (2) total depth (feet) 113'
  - (3) static water level (feet) 19' below above top of ground.
  - (4) casing Steel, 113'  
(material) (depth)  
16" If telescope see back.  
(size)
  - (5) screen 40', 73'  
(length) (depth to top)  
16", Steel  
(size) (material)
  - (6) pump 50, 1100  
(HP) (yield gpm)  
Diesel  
(type power)
  - (7) electric log \_\_\_\_\_  
(yes or no)  
(organization running log)
  - (8) how well bottom plugged slate

description of formations encountered	from	to
Clay	0	25
Fine Sand	25	68
Coarse Sand	68	75
Fine Sand	75	78
Fine-med. Sand	78	80
Medium Sand	80	100
Sand & gravel	100	110
Clay	110	118

CODED


CODED

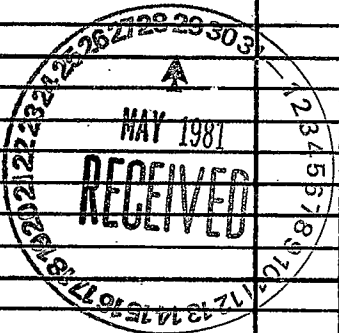

DRILLERS REMARKS:

If well telescopes please sketch and show depths.

GROUND LEVEL

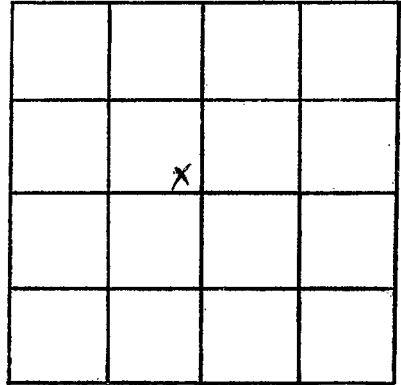

SECTION 26

Please indicate well location X.

ADDITIONAL INFORMATION

If more than one screen, show locations of each on sketch.