

MISSISSIPPI DEPARTMENT OF NATURAL RESOURCES

Bureau of Land and Water Resources

Southport Mall

P.O. Box 10631

Jackson, Mississippi 39209

WATER WELL DRILLERS LOG

Washington
R 41
1-19-81

Jan 19 1981 date well completed
Larry's well & Pump firm name
Washington county well located

LANDOWNER: Sid Law
Chatham, MS.
(mailing address)

description of formations encountered	CODED	
	from	to
clay	0	2.0
fine sand	2.0	3.0
med sand	3.0	5.0
coarse sand/gravel	5.0	11.0

WELL LOCATION:
sec. 14 T 14 N R 9 E
0.8 miles NE of Shalk
(distance) (direction) (nearest town)

WELL PURPOSE:
(home, irrigation, municipal, industrial)

WELL COMPLETION DATA:

(1) diameter (inches) 12"
(2) total depth (feet) 110'
(3) static water level (feet) 10 below above top of ground.
(4) casing Steel, 70' (material) (depth)
(size) if telescope see back.
(5) screen 40' 70' (length) (depth to top)
12" steel (size) (material)
(6) pump 40 2500 (HP) (yield gpm)
(type power)
(7) electric log NO (yes or no)
(organization running log)
(8) how well bottom plugged Steel Plate

DRILLERS REMARKS:


CODED

DEPT. OF NATURAL RESOURCES
BUREAU OF LAND & WATER RESOURCES

JUN 2 - 1981
RECEIVED

If well telescopes please sketch and show depths.

GROUND LEVEL

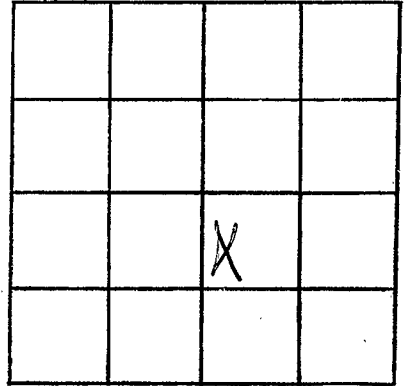

SECTION 14

Please indicate well location X.

ADDITIONAL INFORMATION

If more than one screen, show locations of each on sketch.