

MISSISSIPPI DEPARTMENT OF NATURAL RESOURCES

Bureau of Land and Water Resources

Southport Mall

P.O. Box 10631

Jackson, Mississippi 39209

WATER WELL DRILLERS LOG

CODED

Washington
R42
7-20-81

July 20 1981 date well completed
Larry's well & pump firm name
Washington county well located

LANDOWNER: Charles McKamy

description of formations encountered

from

to

Chatham ms
(mailing address)

Clay	0	35
Fine Sand	35	70
Coarse Sand	70	126

WELL LOCATION:

sec. 16-T-14 N R-9
3 miles SE of Chatham
(distance) (direction) (nearest town)

WELL PURPOSE:

(home, irrigation, municipal, industrial)

WELL COMPLETION DATA:

- (1) diameter (inches) 16"
- (2) total depth (feet) 126'
- (3) static water level (feet) 15 below top of ground.
- (4) casing Steel, 86' (material) (depth)
- (size) if telescope see back.
- (5) screen 40' (length), 86' (depth to top)
- 16" (size), Steel (material)
- (6) pump 60 (HP), 34000 (yield gpm)
- (type power)
- (7) electric log No (yes or no)

CODED

DEPT. OF NATURAL RESOURCES
BUREAU OF LAND & WATER RESOURCES

OCT 19 1981

RECEIVED


(organization running log)

(8) how well bottom plugged Steel plate

DRILLERS REMARKS:

If well telescopes please sketch and show depths.

GROUND LEVEL

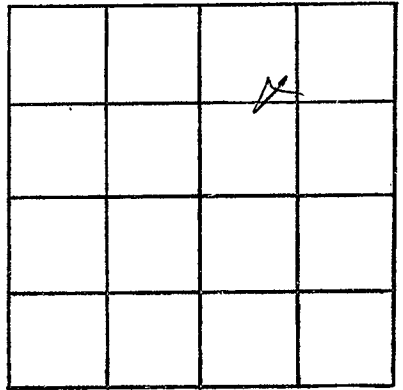

SECTION 16

Please indicate well location X.

ADDITIONAL INFORMATION

Lined area for additional information.

If more than one screen, show locations of each on sketch.